

RECEIVED

CLAIM OF BENEFICIAL USE

AUG 19 1999

APPLICATION NO. 72429 PERMIT NO. 53113

WATER RESOURCES DEPT.  
SALEM, OREGON


SURVEYED JULY 21, 1999 BY DUANE W. KIRBY

FOR: EUGENA WILLIAMS

SECTION 13, T 26 S, R 4 W, W M



1 INCH = 400 FEET

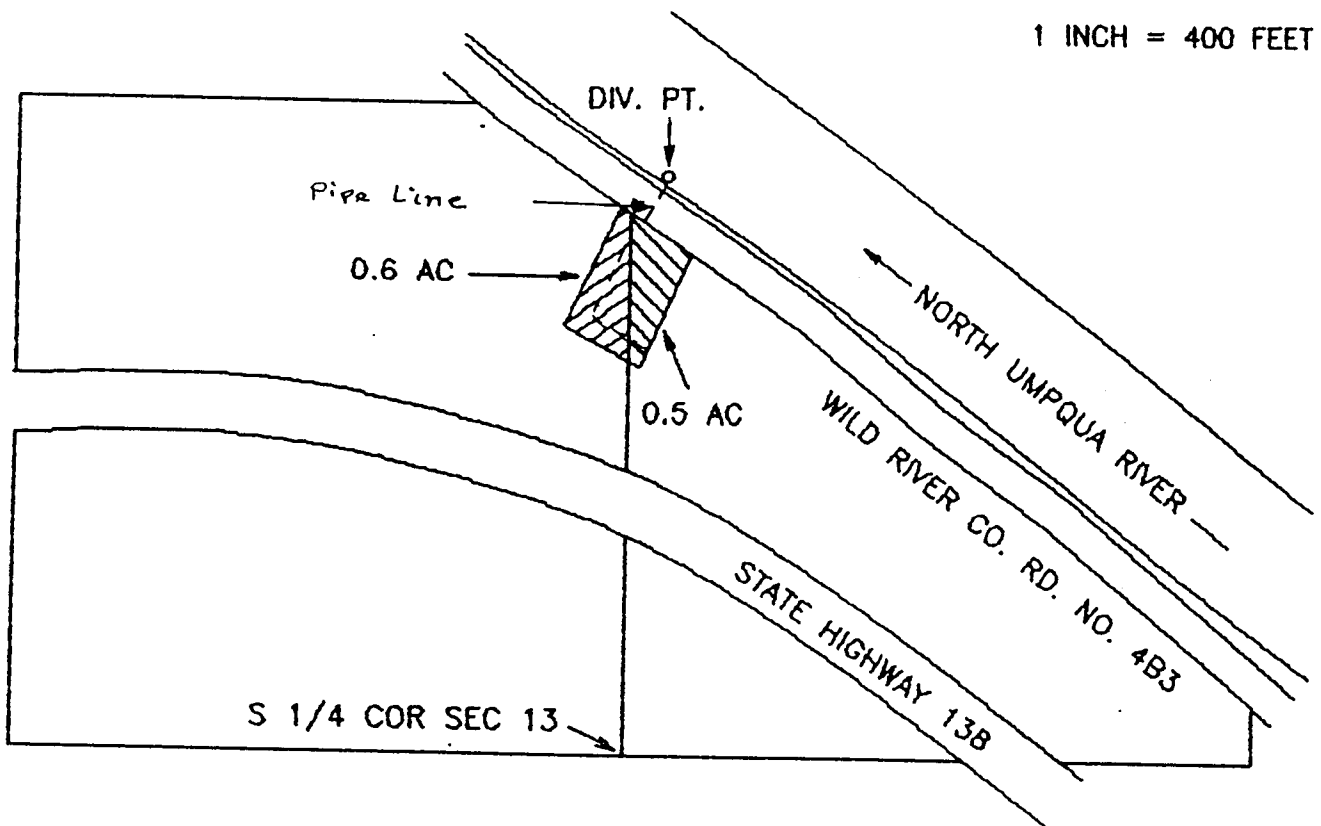

THE PURPOSE OF THIS MAP IS TO IDENTIFY THE LOCATION OF THE WATER RIGHT. IT IS NOT INTENDED TO PROVIDE LEGAL DIMENSIONS OR THE LOCATION OF PROPERTY OWNERSHIP LINES.

