


FINAL PROOF SURVEY MAP  
T24S, R4W, WM  
SCALE 1" = 1320'

DOUGLAS COUNTY

RECEIVED

JAN 28 2002

WATER RESOURCES DEPT.  
SALEM, OREGON

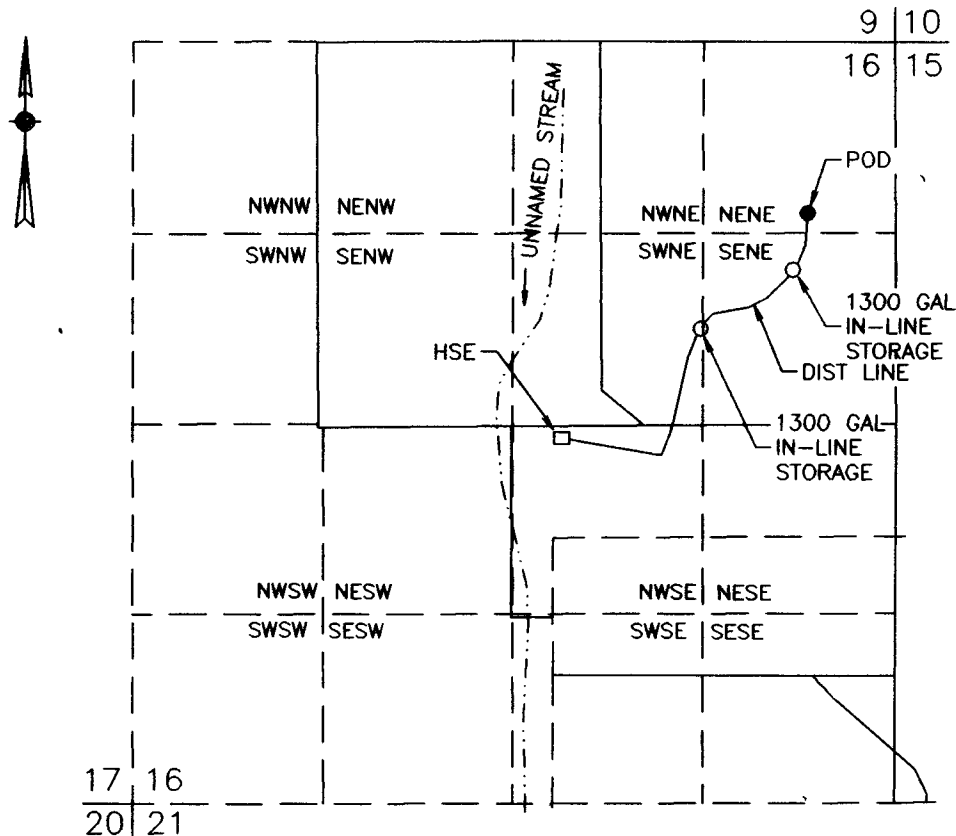

POD IS 1180 FT S AND 590 FT W FROM NE COR SEC 16

FINAL PROOF SURVEY  
UNDER

Application No. S-75261 Permit No. 52964

IN NAME OF

Don & Lisa Melville

Surveyed October 15, 2001 by M E Farr

MAP PREPARED FOR:  
DON AND LISA MELVILLE  
864 LARKSPUR LANE  
OAKLAND, OR 97462

MAP PREPARED BY:  
MAURICE E FARR, CWRE  
395 NE KIRBY AVENUE  
ROSEBURG, OR 97470

THIS IS A LOCATION MAP FOR A FINAL PROOF SURVEY BY DON AND LISA MELVILLE. THIS MAP IS FOR THE PURPOSE OF IDENTIFYING THE LOCATION OF THE WATER RIGHT ONLY AND IS NOT INTENDED TO PROVIDE LEGAL DIMENSIONS OR LOCATIONS OF PROPERTY OWNERSHIP LINES.

