


RECEIVED

OCT 20 1993

WATER RESOURCES DEPT.
SALEM, OREGON

T8S, R35-1/2E, W.M:

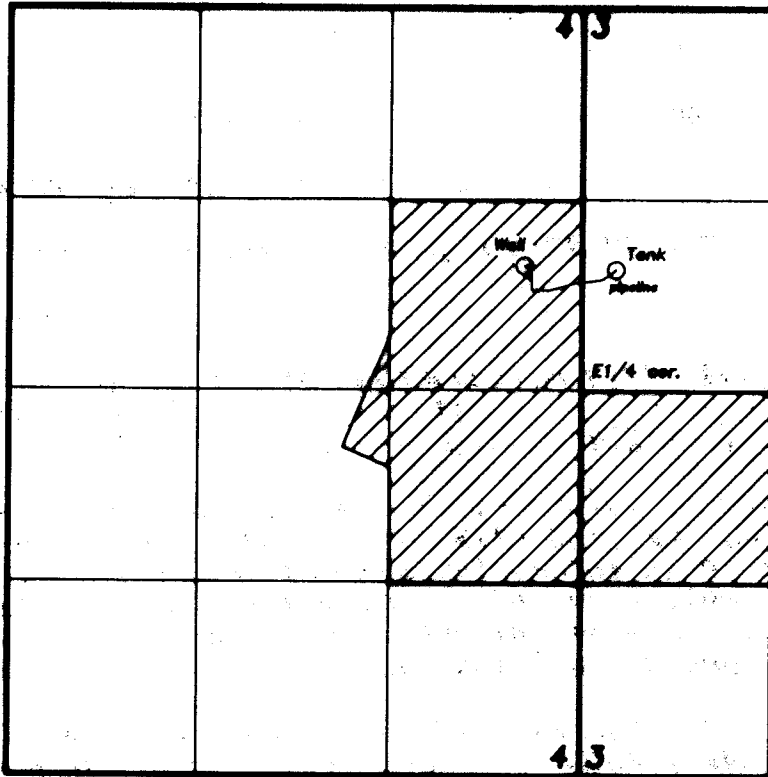


Diversion point is 1000'N. and 300'W. of the E1/4 cor. Sec.4.

SCALE 1"=1320'

FINAL PROOF SURVEY
UNDER

 Granite City Limits

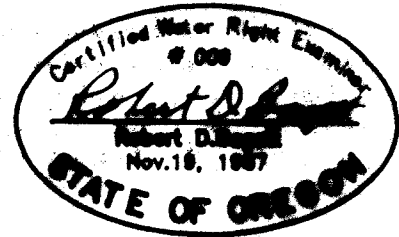

APPLICATION NO. G-12538 PERMIT NO. G-11419

IN NAME OF
CITY OF GRANITE

SURVEYED SEPT. 28, 1993 BY Robert D. Baggett

NOTE: The preparation of this map was for the purpose of identifying the location of the proposed water right and has no intent to provide dimensions or location of property ownership lines.