

TOWNSHIP 15 SOUTH, RANGE 12 EAST, W.M.
SW 1/4 Section 11

C-79908

11

NE 1/4 SW 1/4

1/4 corner

Airstrip

Eagle

Drive

hanger

Well

15'

Barn

40

Buried

1" PVC

house

Hwy 126



1/4 corner

Scale 1" = 400'

Surveyed Sep 1, 2000

Claim of Beneficial Use Map
for
SAM KASER

Application G-13973
Permit G-12989

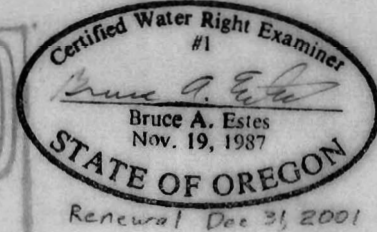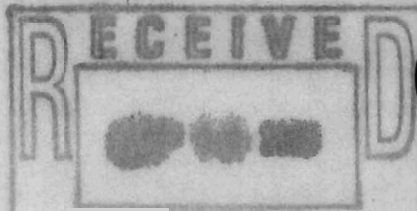

This map is for the purpose of
locating a water right only
and has no intent to provide
legal dimensions or the location
of property lines.

ESTES SURVEYS

PO Box 17519 60382 Arnold Rd
Salem, OR 97305-7519 Bend, OR 97702
(503) 585-7593 (541) 382-7391