


T. 35 S., R. 2 W., W.M.

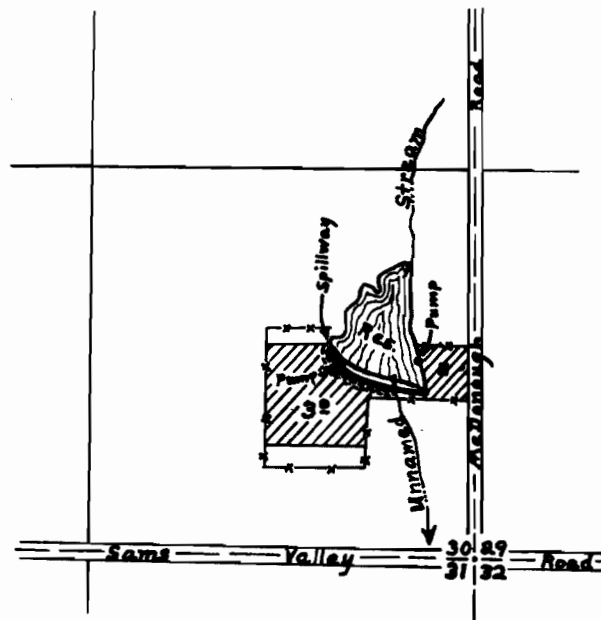

(Scale: 8" = 1 mile)

FINAL PROOF SURVEY UNDER

Application No. R-31868 Permit No. R-2072
31869 25121
IN NAME OF


Ralph A. James

Surveyed March 20, 1962, by D. L. Hendrix

T. 35 S., R. 2 W., W. M.

Sec. 30

SE 1/4 SE 1/4

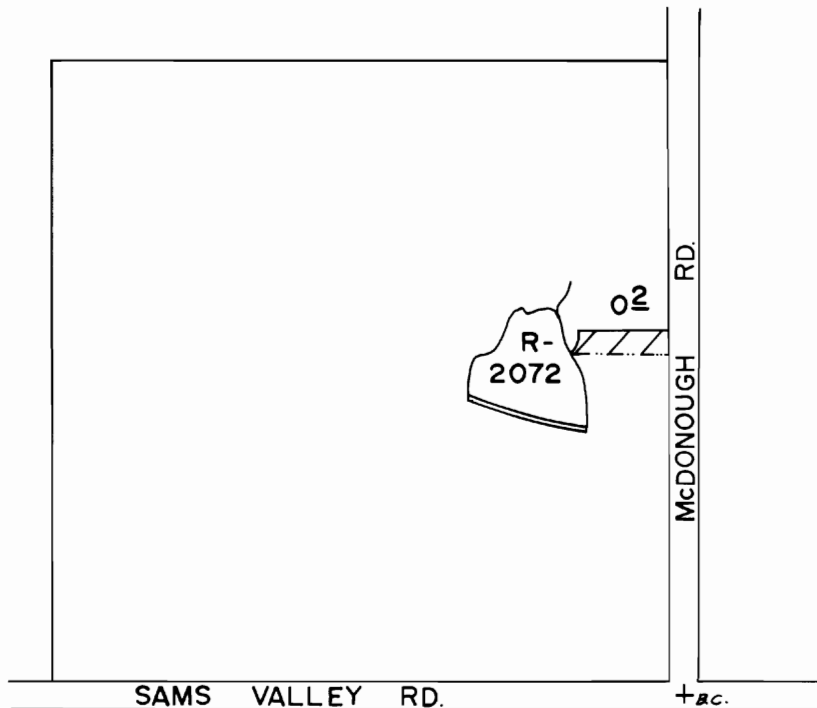

Scale 1" = 400'

FINAL PROOF SURVEY
UNDER

Transfer No. 4714

Application No. Permit No.
IN NAME OF

LARRY L. & SUZANNE G. RICH

Surveyed Oct. 4 19.84, by J. R. WOODROOF