


# T. 6S. R. 6 & 7. W. W.M.

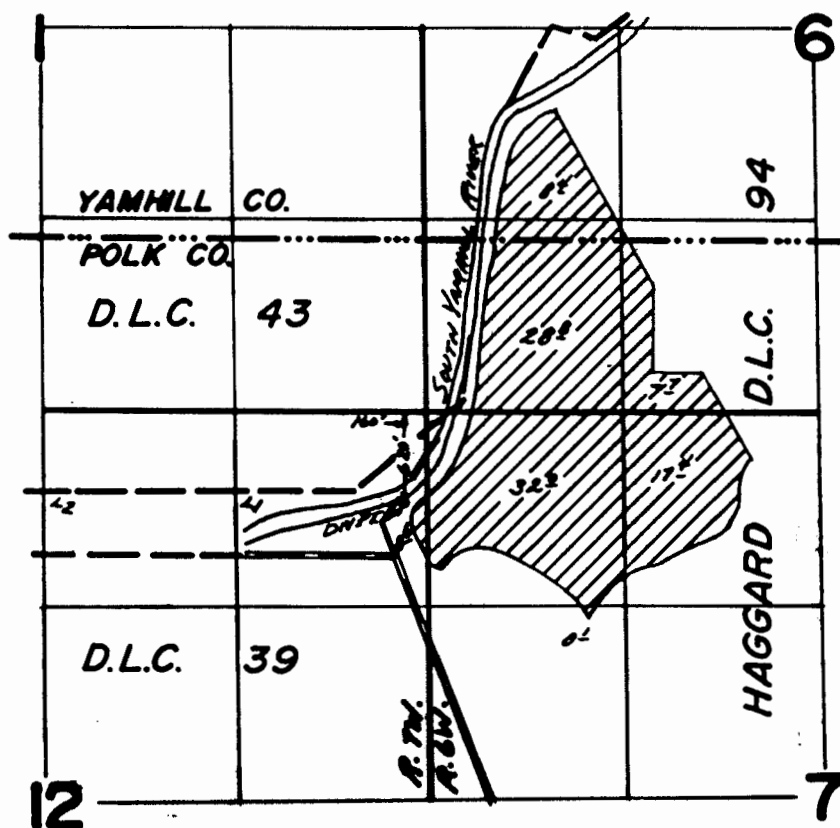

## FINAL PROOF SURVEY UNDER

Transfer No. 3971 — (RICHARD KIRKHAM)  
Application No. 17629... Permit No. 13313....  
IN NAME OF

.....WILLIAM.....SCHULZ.....

Surveyed July 13, 1954, by T. JONES.....