


T. 28 S. - R. 12 W., W.M.

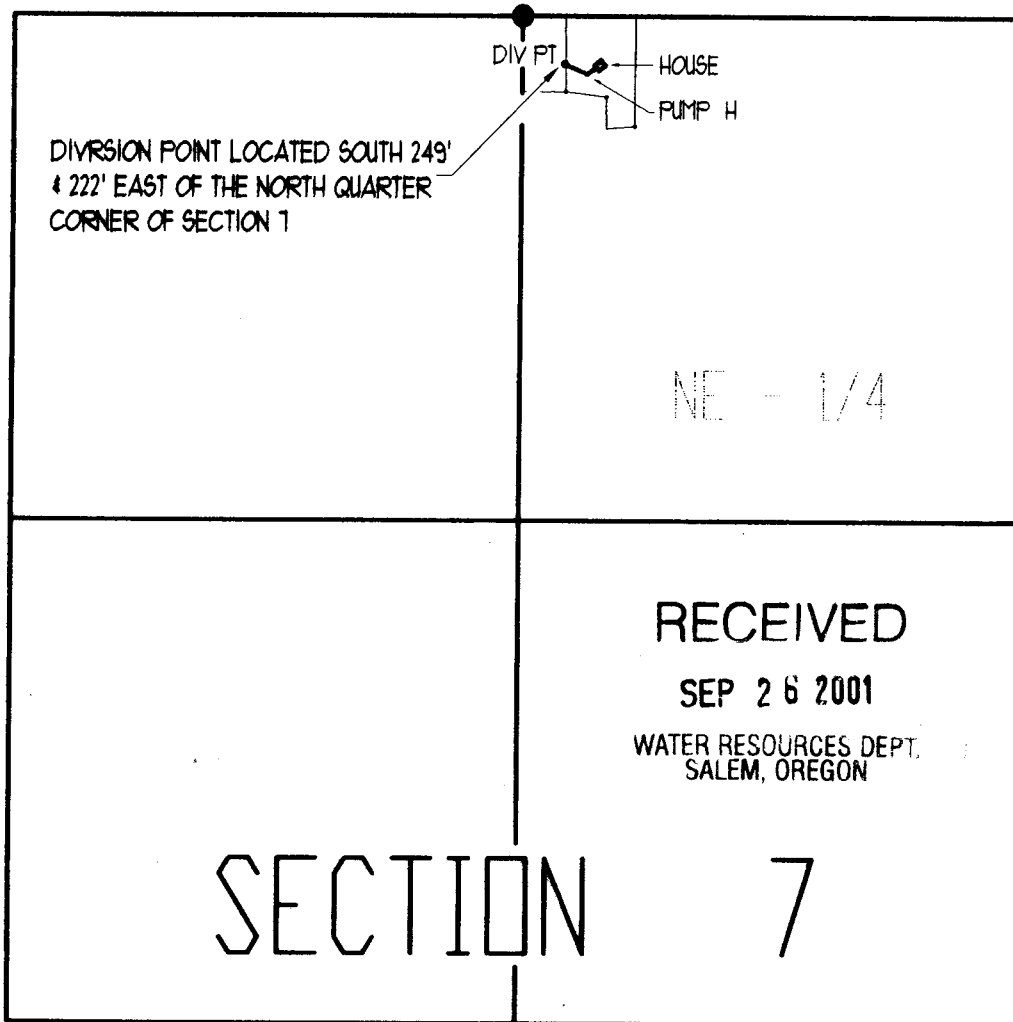

SCALE: 1" = 1000'

FINAL PROOF SURVEY

APPLICATION NO. 51059 PERMIT NO. 38528
IN THE NAME OF
PATRICK AND THIERY McPHERSON
SURVEYED SEPTEMBER 14 2001, BY RUSS DODGE

