



Township 5 South Range 1 East, W.M.
 Portions of Sections 25 & 26

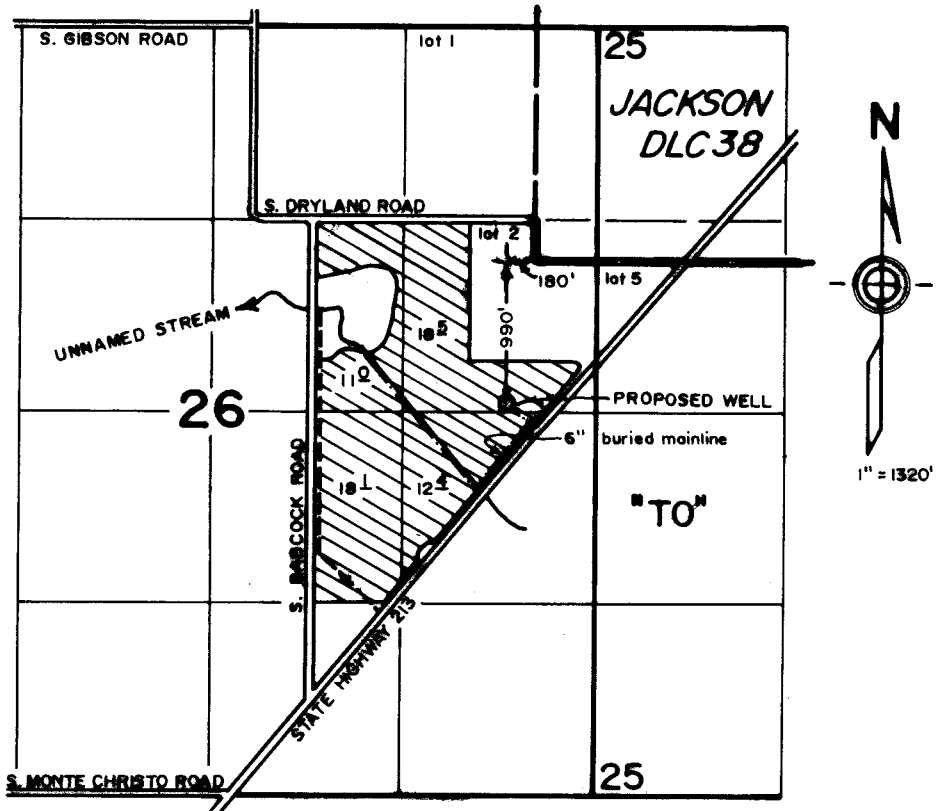

FINAL PROOF SURVEY
 under
 Transfer 6591
 in name of
KRAEMER FARMS
 September 21, 1993

OFFICE
 OCT 08 1993
 WATER RESOURCES
 DIVISION

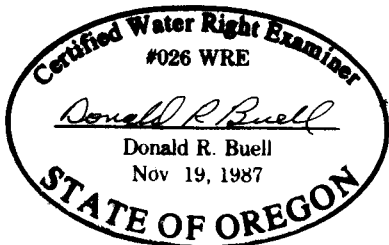

THIS MAP WAS PREPARED FOR THE PURPOSE OF IDENTIFYING THE LOCATION OF A WATER RIGHT ONLY AND IS NOT INTENDED TO PROVIDE LEGAL DIMENSIONS OR LOCATION OF PROPERTY OWNERSHIP LINES.