


T.5 N.R.26 E.W.M.

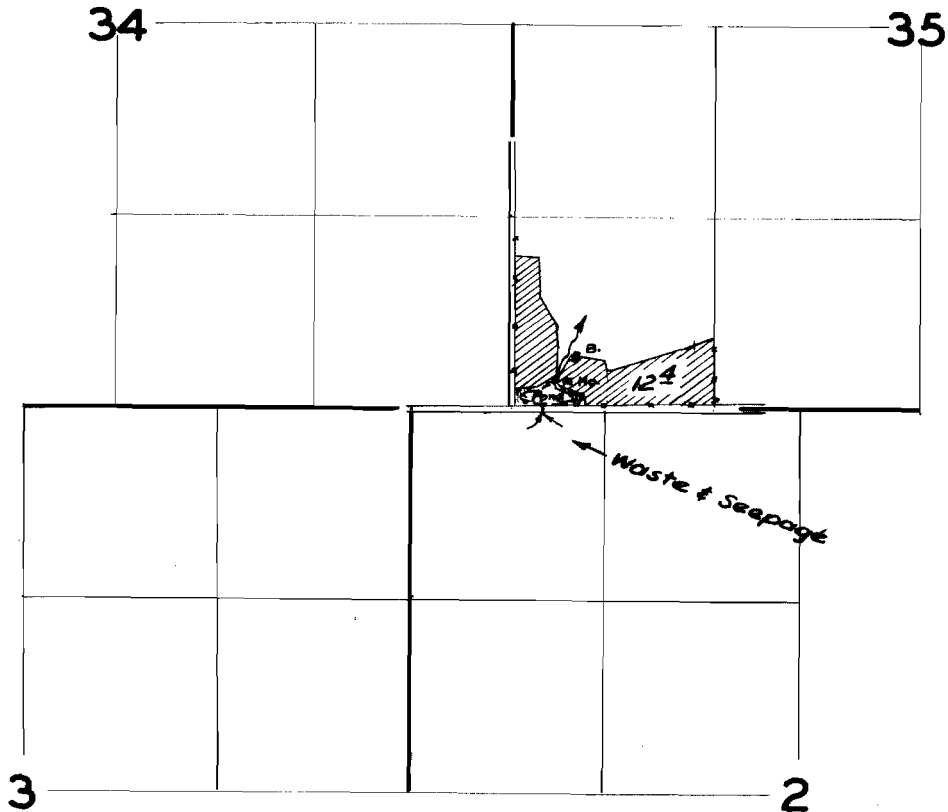

**FINAL PROOF SURVEY**  
UNDER

Application No. 29839 Permit No. 23959  
IN NAME OF

LLOYD W. HAYMOND

Surveyed 12 Oct. 1958, by M. Bish