


T. 5N., R. 26E., W. M.

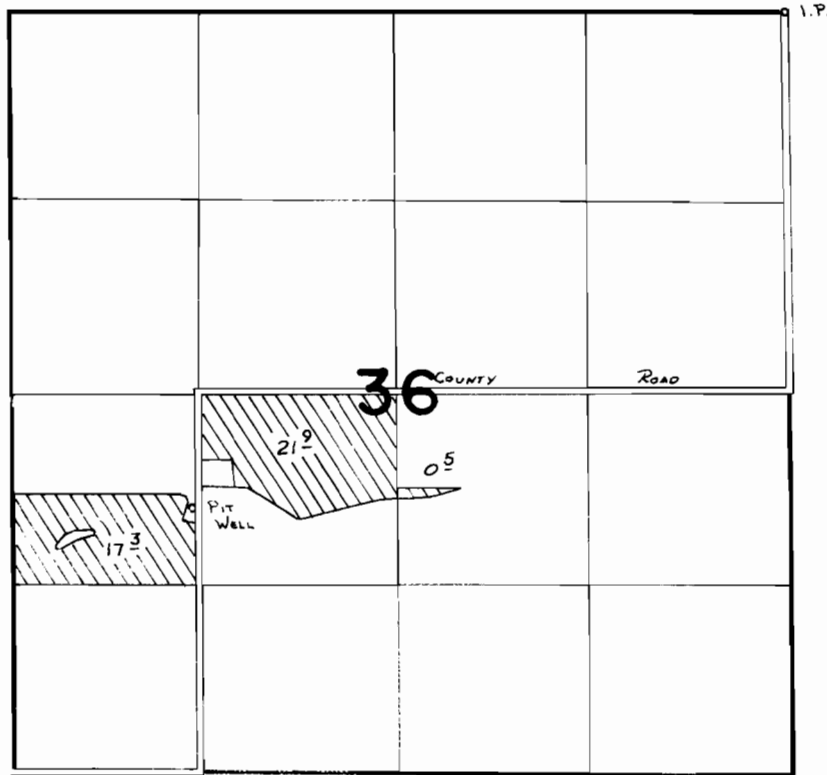

PIT WELL Loc: 770' S. & 1400' W. FROM CENTER COR. SEC. 36

FINAL PROOF SURVEY
UNDER

SCALE: 1" = 1320'

Application No. **G:5894** Permit No. **G:5039**
IN NAME OF

MRS. BARBARA VOLLE

Surveyed **4.7.1978.** by **R. BARWID**