


T.1N.,R.14E.,W.M.

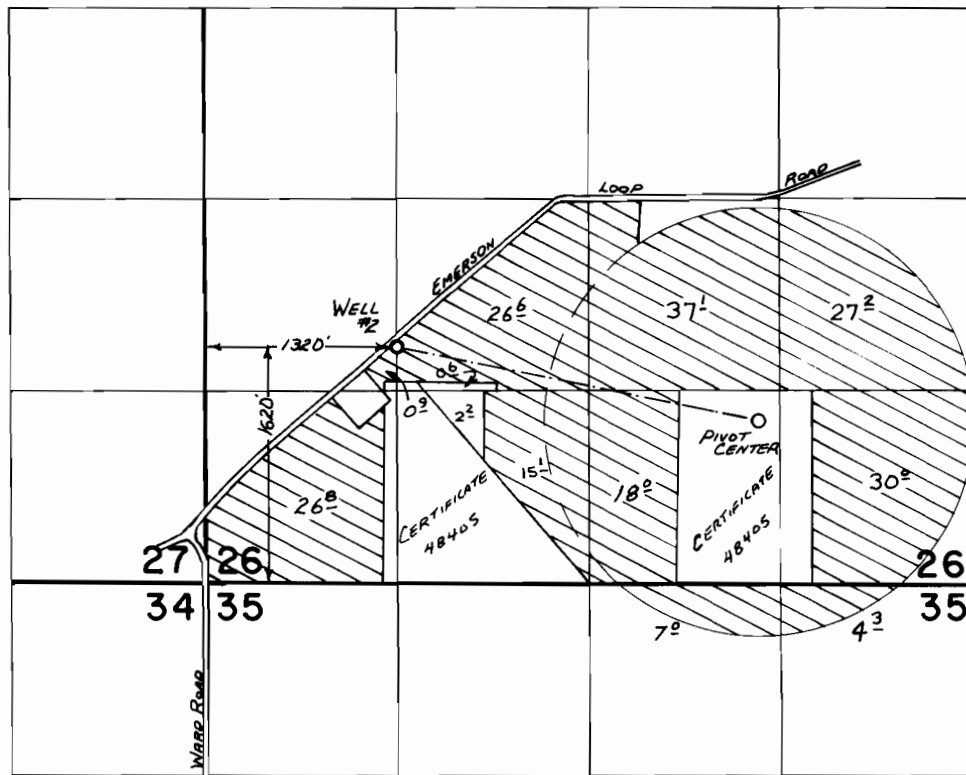

FINAL PROOF SURVEY UNDER

Application No. G-7438 Permit No. G-7258
IN NAME OF

GEORGE HARTH

Surveyed Sept. 20, 1982, by T.J. Paul