


RECEIVED

MAY 26 1996

WATER RESOURCES DEPT  
SALEM, OREGON


# T.34S.,R.1W.,W.M.

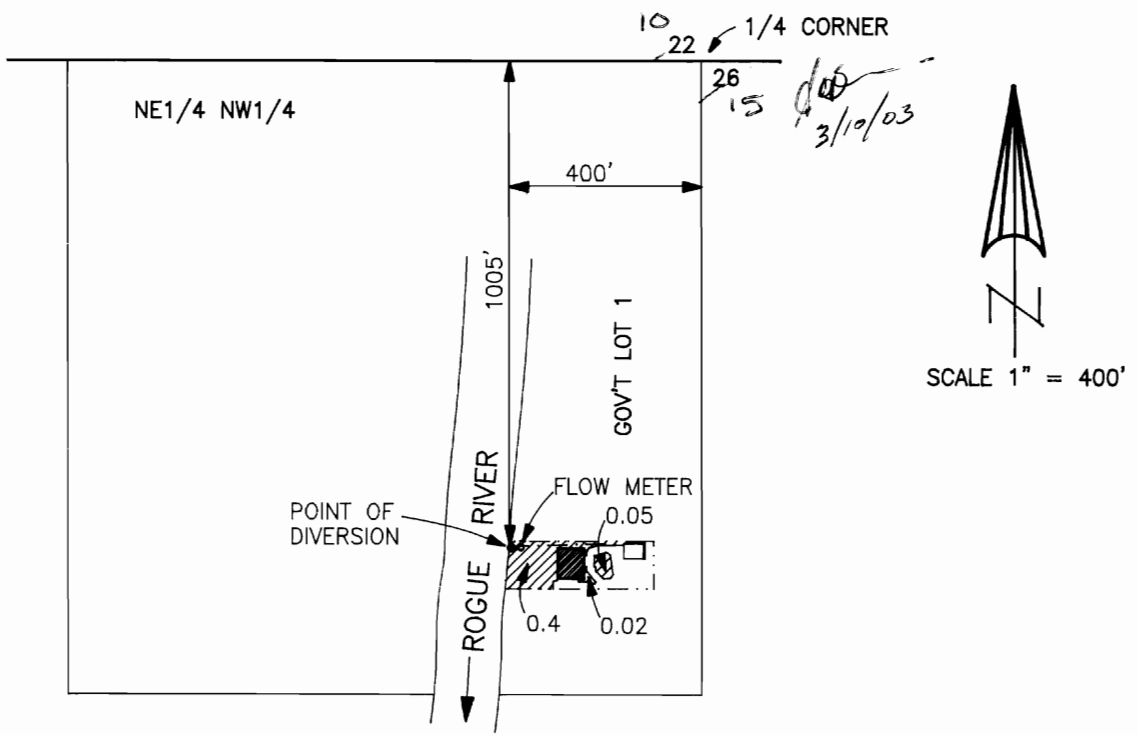

NOTE: MAP PREPARED FOR  
WATER RIGHT PURPOSES ONLY,  
NOT FOR PROPERTY BOUNDARY  
LOCATIONS.

FINAL PROOF MAP  
APPLICATION No. T-7566. PKS

IN THE NAME OF  
JAMES VAN ORSOW

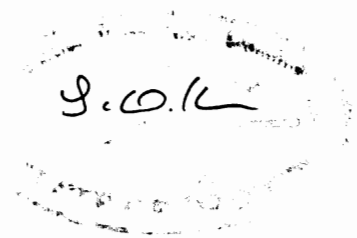

MAP PREPARED APRIL 26, 1999 BY GARY D. KAISER