


T.6S. R.7W.W.M.

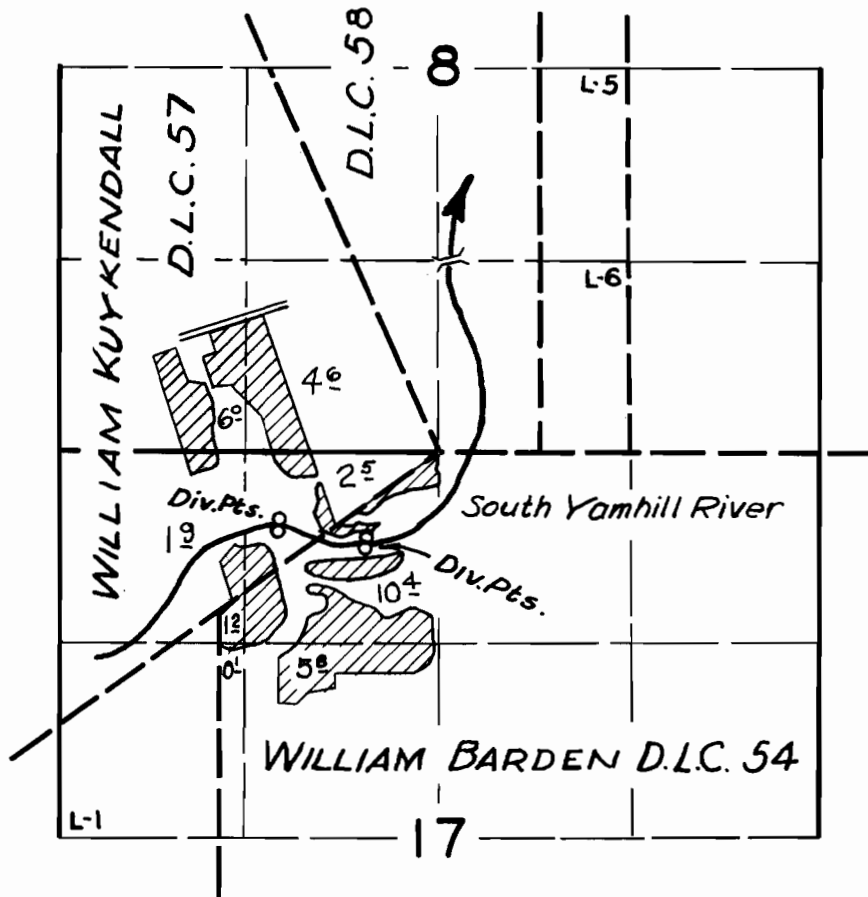

FINAL PROOF SURVEY
UNDER

Application No. 22562 Permit No. 17821
IN NAME OF

ALFRED WERTH

Surveyed April 21 1958, by R.H. Whitby