


**FINAL PROOF SURVEY MAP  
IN THE NAME OF ARIC AND JACQUELYN GROSHONG**

APPLICATION S-83942


PERMIT 53604

SECTION 19, TOWNSHIP 26 SOUTH, RANGE 5 WEST, W.M.

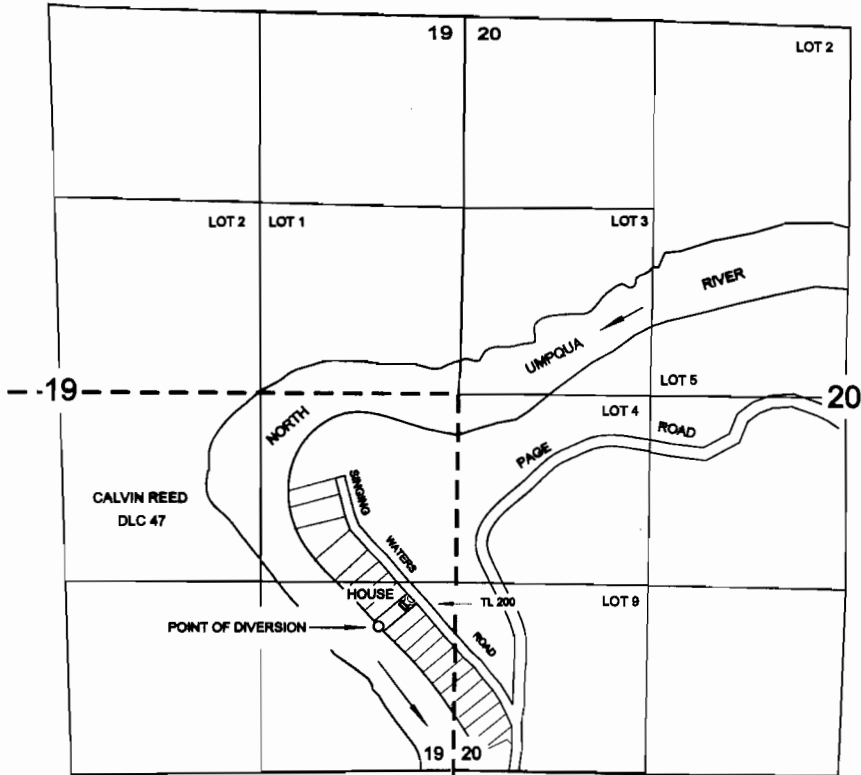

THE POINT OF DIVERSION IS LOCATED 1000 FEET NORTH AND 490 FEET WEST FROM THE SOUTHEAST CORNER OF SECTION 19, BEING WITHIN THE SE $\frac{1}{4}$  SE $\frac{1}{4}$ , AS PROJECTED WITHIN CALVIN REED D.L.C. 47, OF SECTION 19, TOWNSHIP 26 SOUTH, RANGE 5 WEST, W.M.; DOUGLAS COUNTY.

**RECEIVED**  
NOV 14 2002  
WATER RESOURCES DEPT  
SALEM, OREGON

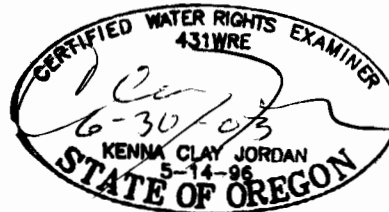

THE PURPOSE OF THIS MAP IS TO IDENTIFY THE LOCATION OF THE WATER RIGHT. IT IS NOT INTENDED TO PROVIDE INFORMATION RELATIVE TO THE LOCATION OF PROPERTY OWNERSHIP BOUNDARY LINES.