


T.11S., R.4W., W.M.

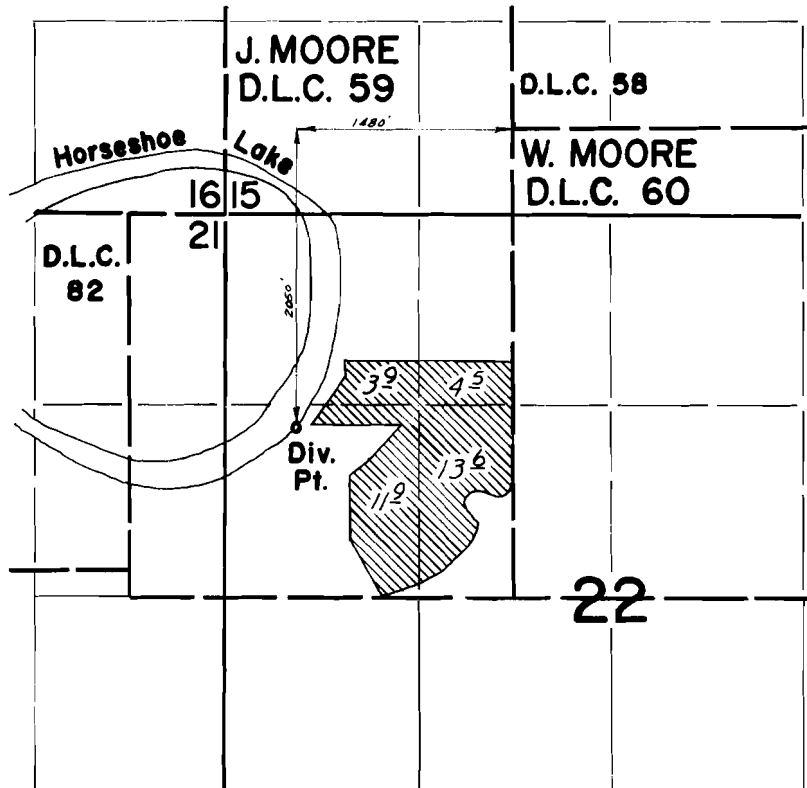

**FINAL PROOF SURVEY**  
UNDER

Application No. 46362 Permit No. 34633  
IN NAME OF

GEORGE L. AND LOUISE M. SCHLEGEL

Surveyed Oct. 1, 1973, by D. Norby