


T. 8 S. R. 19 E. W. M.

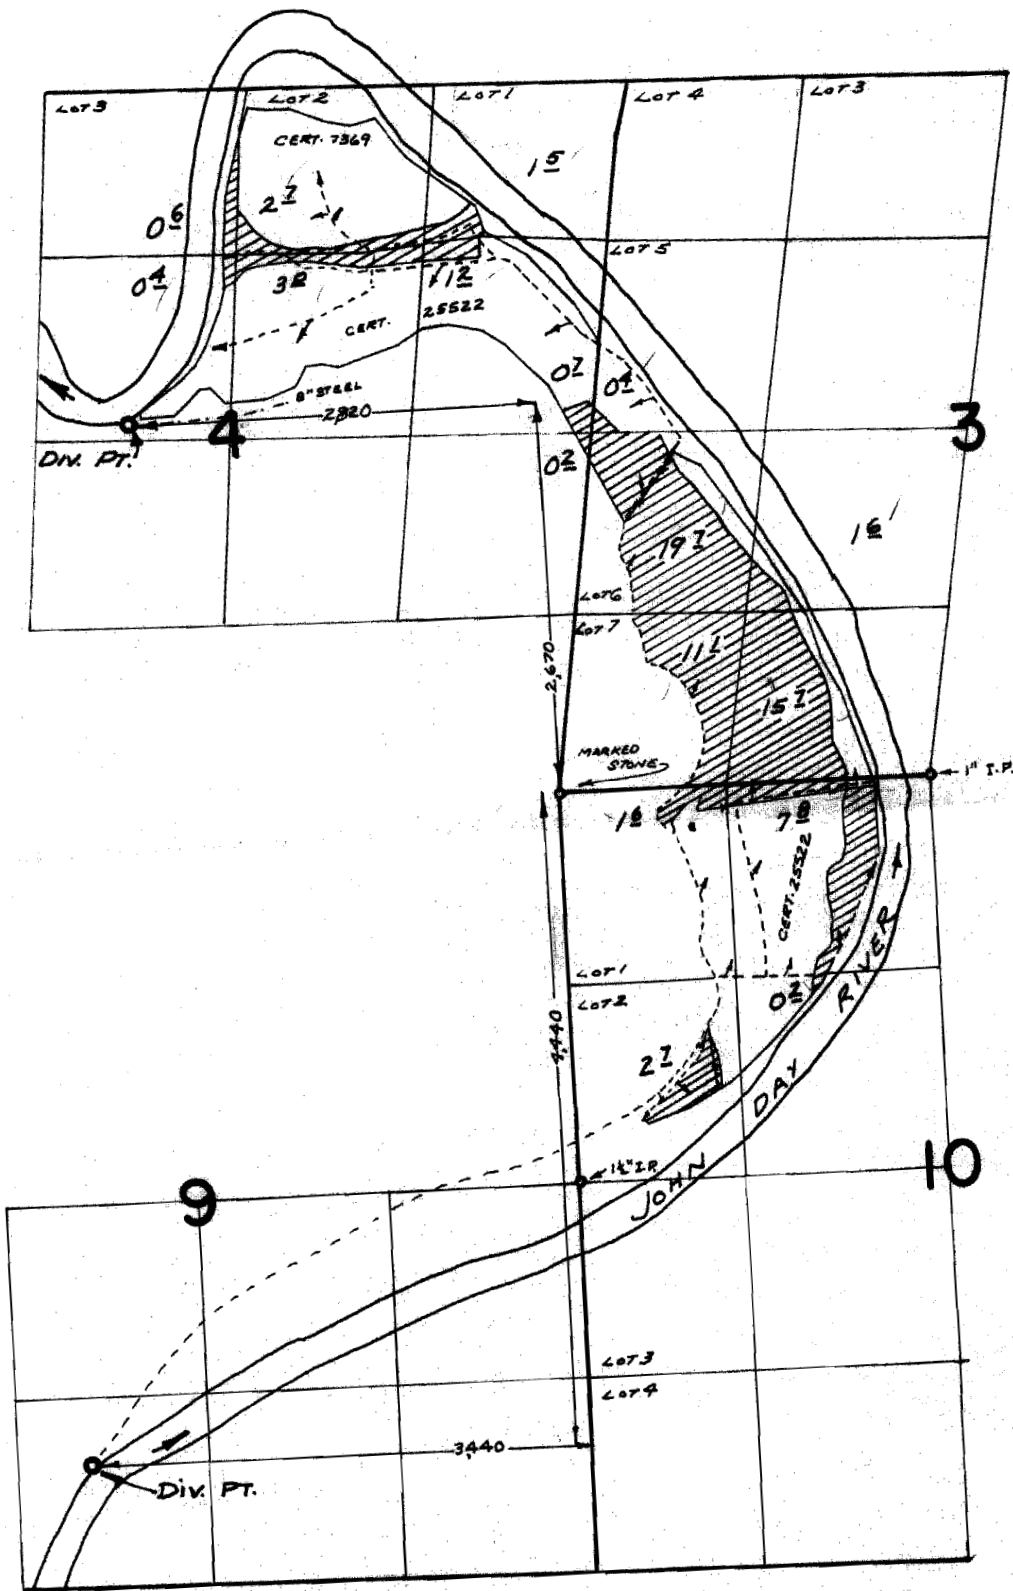

FINAL PROOF SURVEY

UNDER

Application No. 40687 Permit No. 30248

IN NAME OF

ARTHUR L. MCGREER

Surveyed Nov 24 1971, by R. MUCKEN