


T.32S, R.14W, W.M.

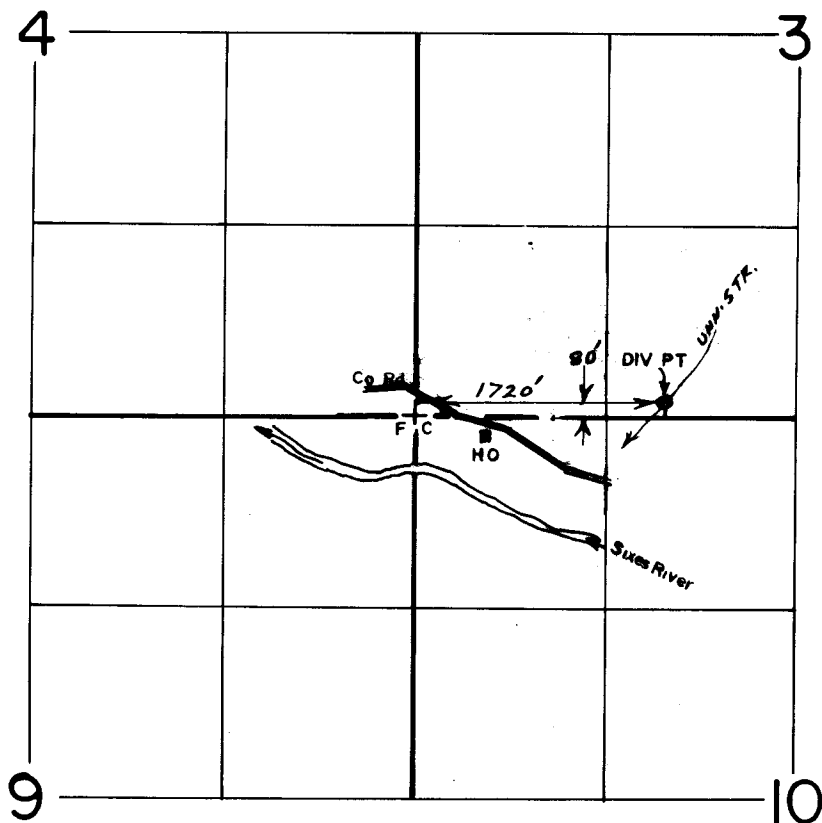

SCALE: 1" = 1320'

FINAL PROOF SURVEY
UNDER

Application No. 65821.... Permit No. 48072.....
IN NAME OF

.....**CHRISTOPHER D. HAWTHORNE**.....

Surveyed JULY 31.... 1989., by B.S. JAMES.....

RECEIVED
FEB 27 2003
WATER RESOURCES DEPT
SALEM, OREGON