


SECTION 36, T28S, R5W, WM

EXPIRES DEC. 31.2002

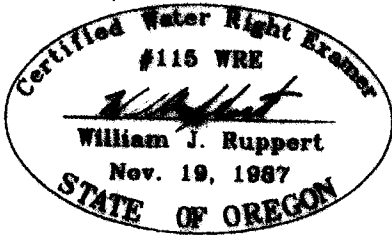

AUGUST, 2001
REVISED 9-16-02
WILLIAM J. RUPPERT
P.O. BOX 1564
MYRTLE CREEK, OR 97457

NW1/4
SE1/4

SW1/4
SE1/4

NE1/4
SE1/4

SE1/4
SE1/4

HOUSE STOCKWATER TROUGH

RES #1
STOCKWATER RESERVOIR

UNNAMED
DRAINAGE

1/4 COR

T29S

1 6

PERMIT 53281 & PERMIT R-12056

THIS MAP IS TO BE USED FOR WATER RIGHT PURPOSES ONLY
MAP TO ACCOMPANY CLAIM OF BENEFICIAL USE

0 400 800
SCALE

IN NAME OF

Gerald & Jeanette A. Clark

WATER RESOURCES DEPT
SALEM, OREGON

SEP 29 2002

RECEIVED

POD #1 FND BC

15 290
1/4 COR

600 GAL.
PLASTIC TANK

1400 GAL.
PLASTIC TANK

500 GAL STEEL TAN

APPROX. PIPE LINE

UNNAMED DRAINAGE

R4W

R5W

1033

T28S

36

31