


SECTION 36, T28S, R5W, WM

EXPIRES DEC. 31.2002

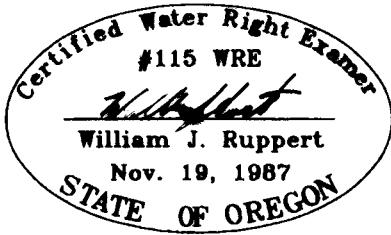

AUGUST, 2001
REVISED 9-16-02
WILLIAM J. RUPPERT
P.O. BOX 1564
MYRTLE CREEK, OR 97457

NW1/4
SE1/4

SW1/4
SE1/4

NE1/4
SE1/4

SE1/4
SE1/4

SPRING

POD #1 FND BC

15' 290'
1/4 COR

600 GAL.
PLASTIC TANK

1400 GAL.
PLASTIC TANK

500 GAL STEEL TAN

APPROX. PIPE LINE
UNNAMED DRAINAGE

RES #1
STOCKWATER RESERVOIR

1126

R4W
R5W

1033

UNNAMED
DRAINAGE

HOUSE
STOCKWATER TROUGH

T28S 36
T29S 1 6

1/4 COR

PERMIT 53281 & PERMIT R-12056

THIS MAP IS TO BE USED FOR WATER RIGHT PURPOSES ONLY

MAP TO ACCOMPANY CLAIM OF BENEFICIAL USE

0 400 800
SCALE

IN NAME OF

Gerald & Jeanette A. Clark

WATER RESOURCES DEPT.
SALEM, OREGON

SEP 23 2002

RECEIVED