


T. 7 S., R 45 E., W. M.

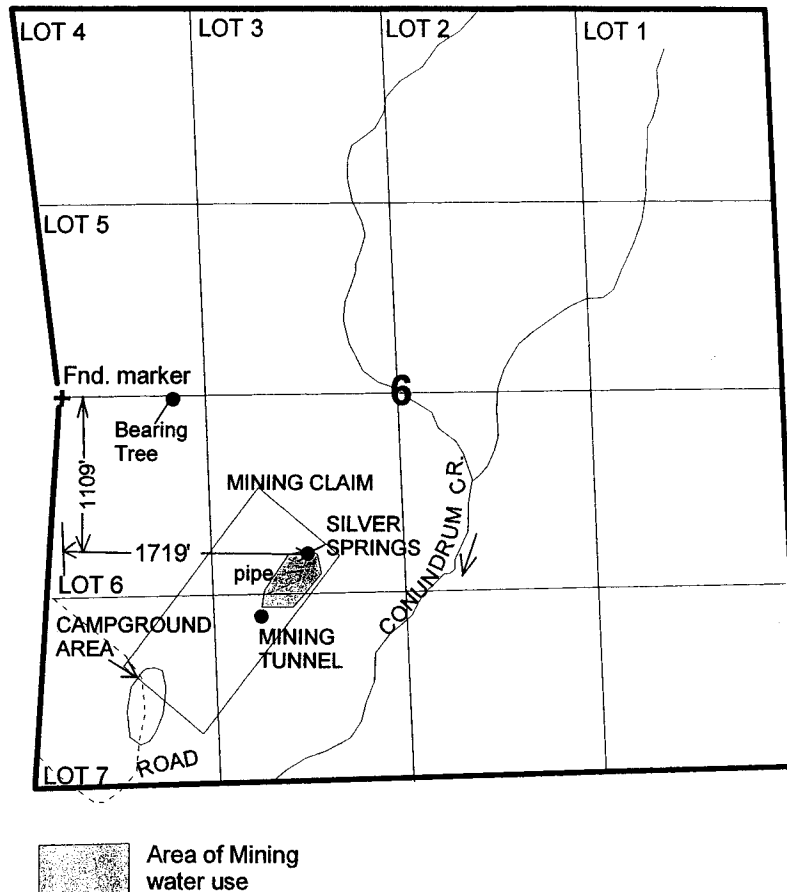

1" = 1320'

**FINAL PROOF SURVEY
UNDER**

Application No. 60098 Permit No. 46672

IN THE NAME OF

CARL ANDREW CARNAGEY

Surveyed July 11, 2002 By J. Miller

RECEIVED

SEP 19 2002

**WATER RESOURCES DEPT.
SALEM, OREGON**