

RECEIVED

AUG 31 1998



WATER RESOURCES DEPT.
SALEM, OREGON



Scale: 1" = 200 ft.

Point of Diversion No. 1 is 510 ft.
North and 1,100 ft. East of the
south 1/4 corner Section 10.

Point of Diversion No. 2 is 410 ft.
North and 1,120 ft. East of the
south 1/4 corner Section 10. Both
POD's are in T 26 S, R 3 W, W. M.

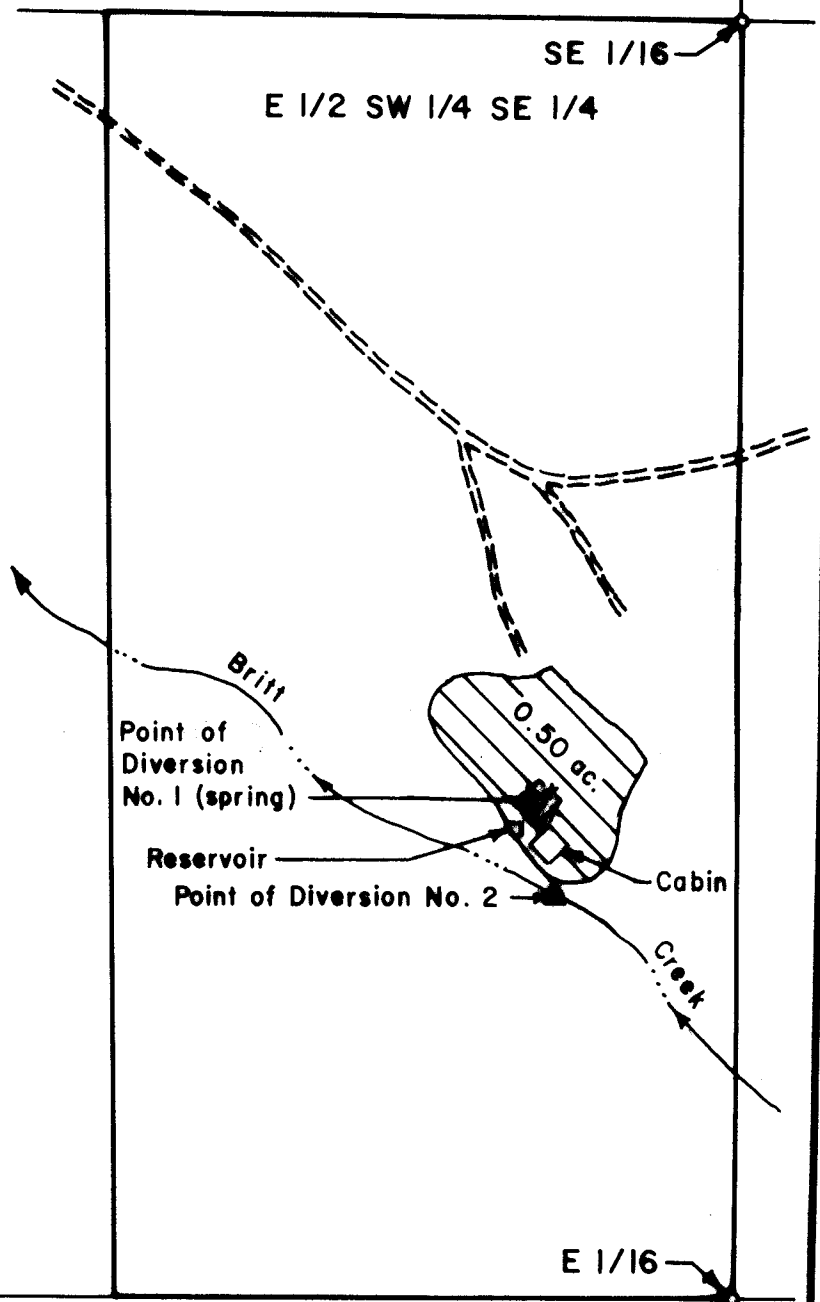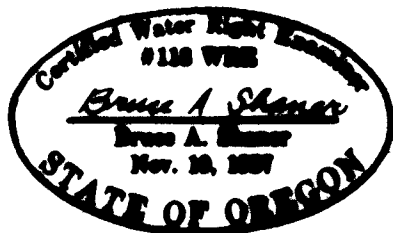

**FINAL PROOF SURVEY OF A
PERMIT TO APPROPRIATE SURFACE
WATER FROM THE E 1/2 SW 1/4 SE 1/4
OF SECTION 10, T 26 S, R 3 W, W. M.,
DOUGLAS COUNTY, OREGON**

**Application No. S-71955
Permit No. 52982**

For: Johann J. Spross
747 Braunda Drive
Roseburg, Oregon 97470

By: Shaner Engineering, Inc.
P. O. Box 1430
Roseburg, Oregon 97470

August 26, 1998