


NOTE:

THIS MAP IS FOR THE PURPOSE OF IDENTIFYING THE LOCATION OF THE WATER RIGHT ONLY AND IS NOT INTENDED TO PROVIDE LEGAL DIMENSIONS OR LOCATION OF PROPERTY OWNERSHIP LINES.

**T.4S, R.1E, W.M.
SEC. 25, 26 & 35**

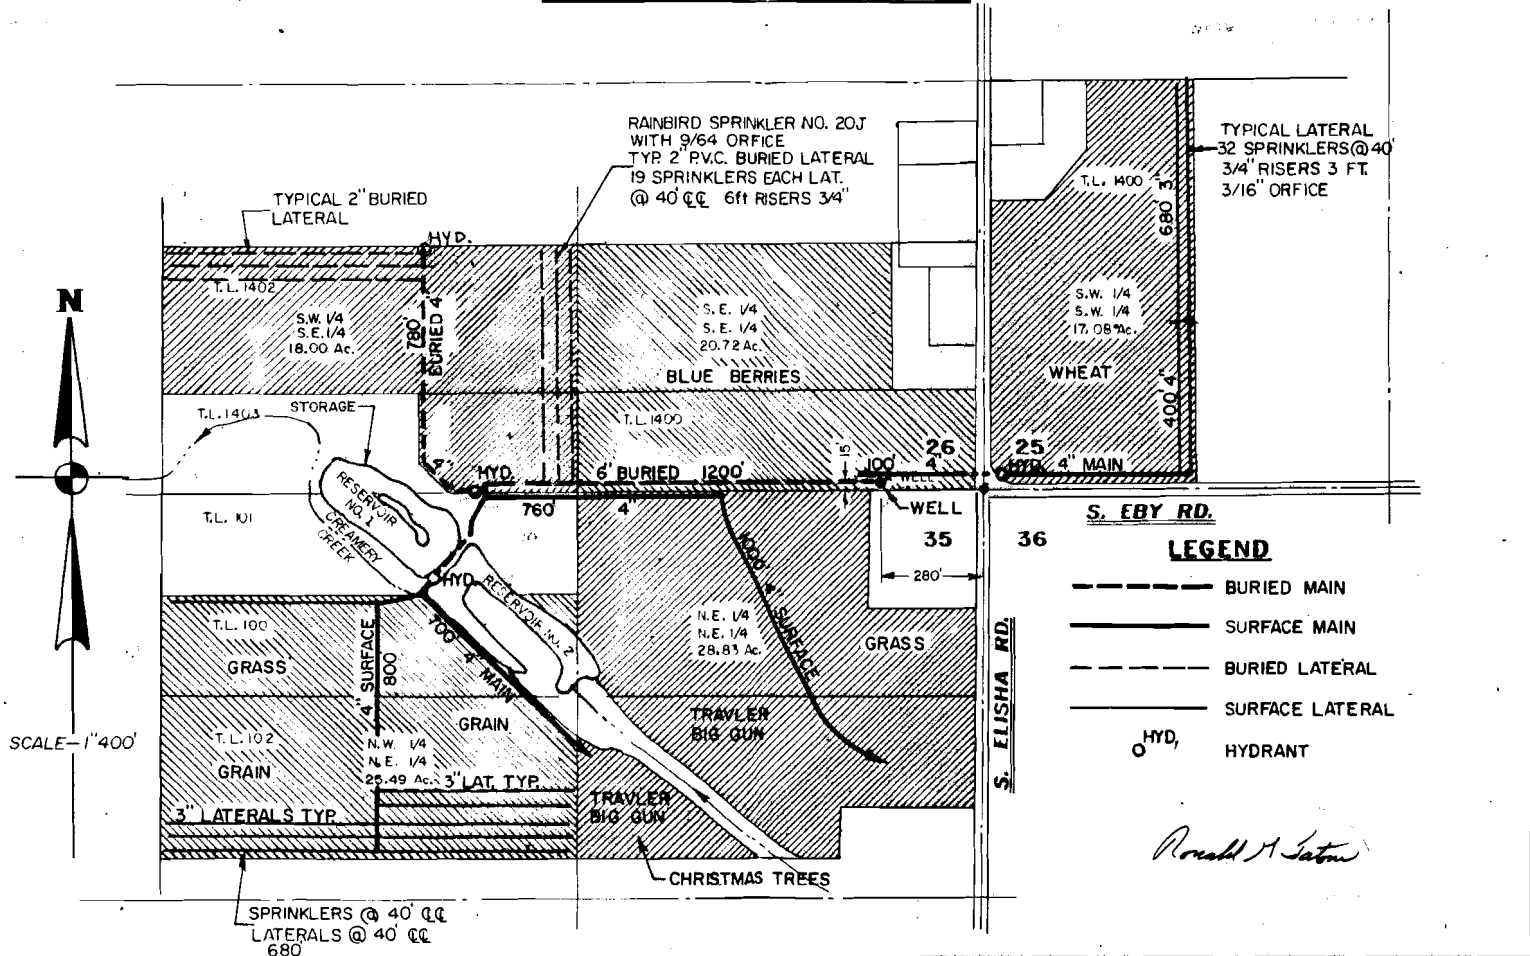

SCALE-1"=400'

PERMIT NO. G-12126
APPLICATION NO. G-13449

**FINAL PROOF SURVEY
FOR
MAYNARD NOFZIGER**

ZTec ENGINEERS, INC.
3737 S.E. 8TH AVE., PORTLAND, OR. 97202
PHONE: (503) 235-8795
FAX: (503) 233-7889

Ronald A. Satou