


T 4 S. R. 11 E. W. M.

*7-6-71
Edgar Mucken
Round Prairie Ditch Co. 34774
4/85*

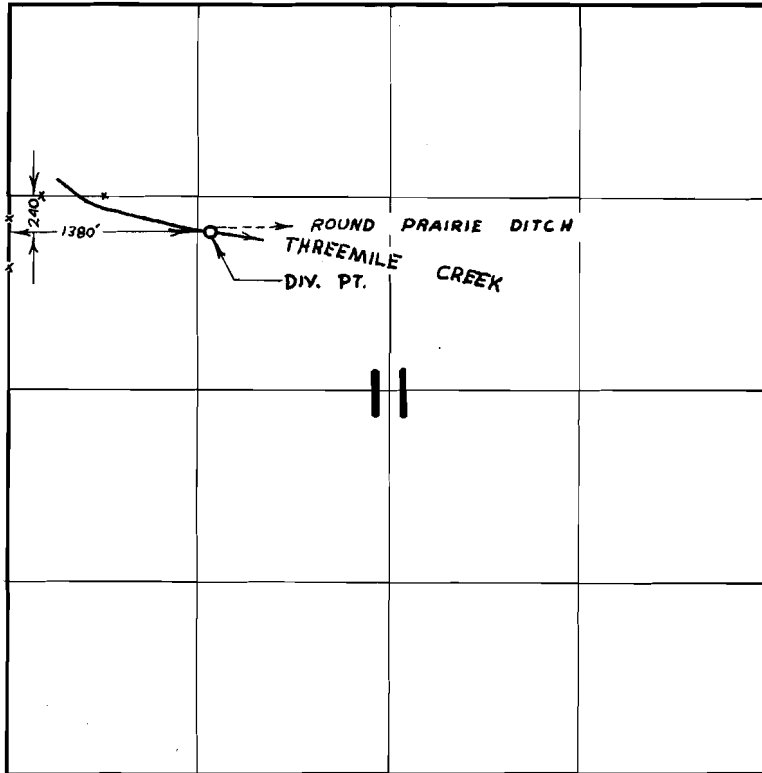

FINAL PROOF SURVEY
UNDER

Application No. 40389 Permit No. 30206
IN NAME OF

ROUND PRAIRIE WATER DITCH COMPANY

Surveyed NOV 12, 1971, by R. MUCKEN