


Map for Certificate 79991

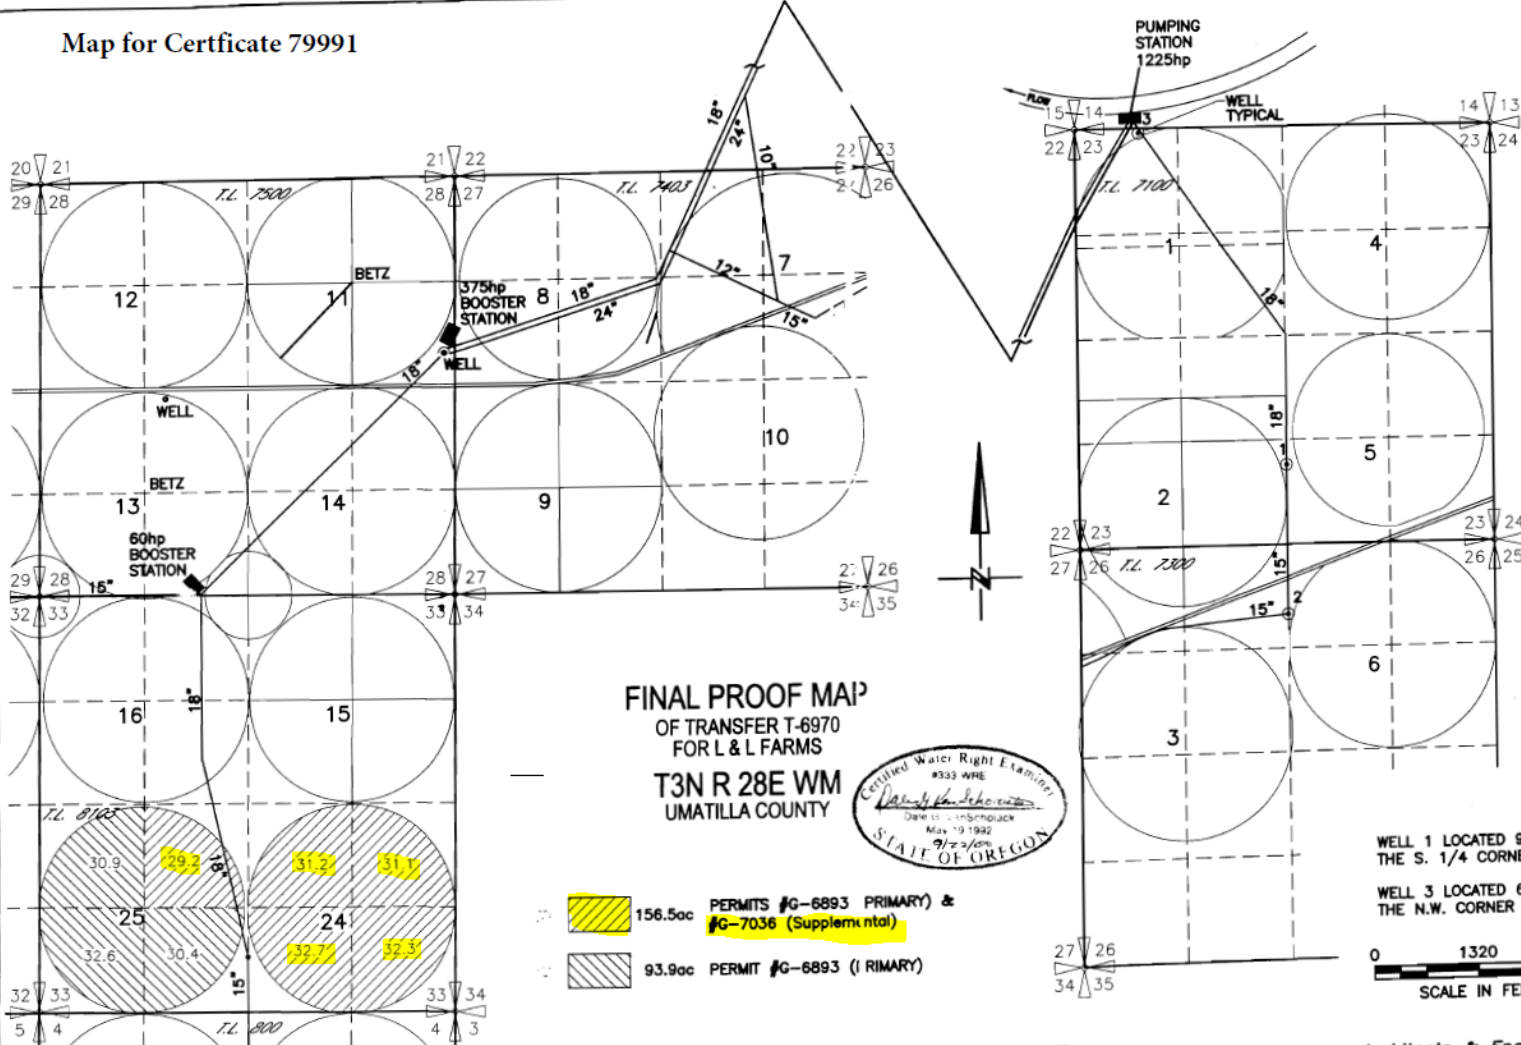

NOTE: THE PURPOSE OF THIS MAP IS TO IDENTIFY THE APPROXIMATE LOCATION OF THE WATER RIGHT. IT IS NOT INTENDED TO PROVIDE INFORMATION RELATIVE TO THE LOCATION OF PROPERTY OWNERSHIP BOUNDARY LINES.

**SCM** Consultants, Inc. Architects & Engineers  
 Kennewick, WA 99336  
 9/21/00  
 3522.005  
 3522LLFP.DWG