


T. 3N. R. 28E. W. M.

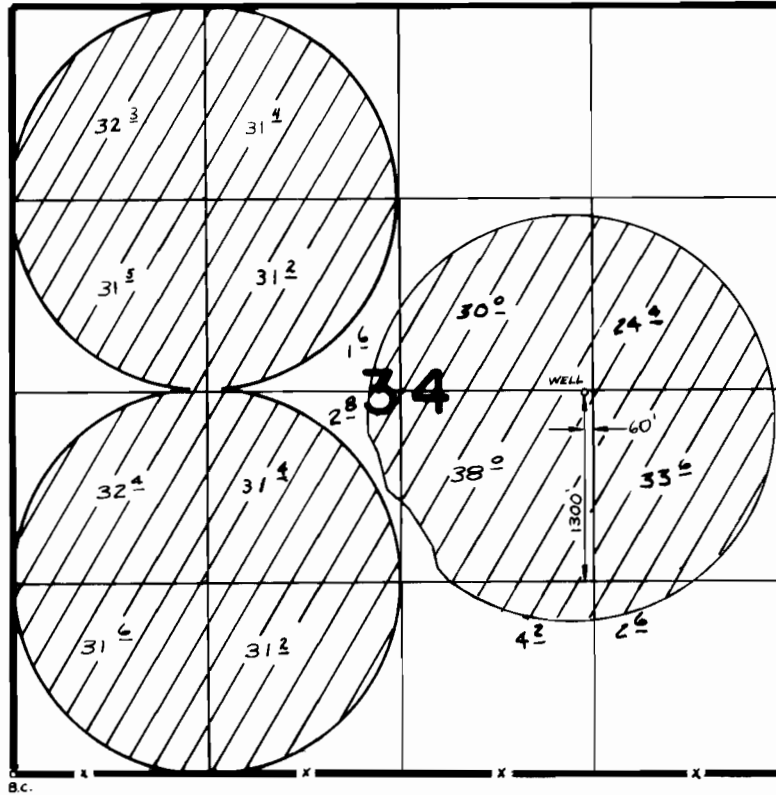

FINAL PROOF SURVEY
UNDER

5-11-78
02-10-1980
WATER RESOURCES DEPT.
SALEM OREGON

Application No. **G-5820** Permit No. **G-5812**
IN NAME OF

.....*David Sparks*.....

Surveyed *4-30* 19*78*, by *R. BARWIN*.....