



T7N & T8N, R5W & R6W, WM  
 CLATSOP COUNTY  
 COLUMBIA COUNTY

**FINAL PROOF SURVEY**  
 UNDER

**WESTPORT WATER ASSOCIATION**

APPLICATION NO. 5-72378  
 4183  


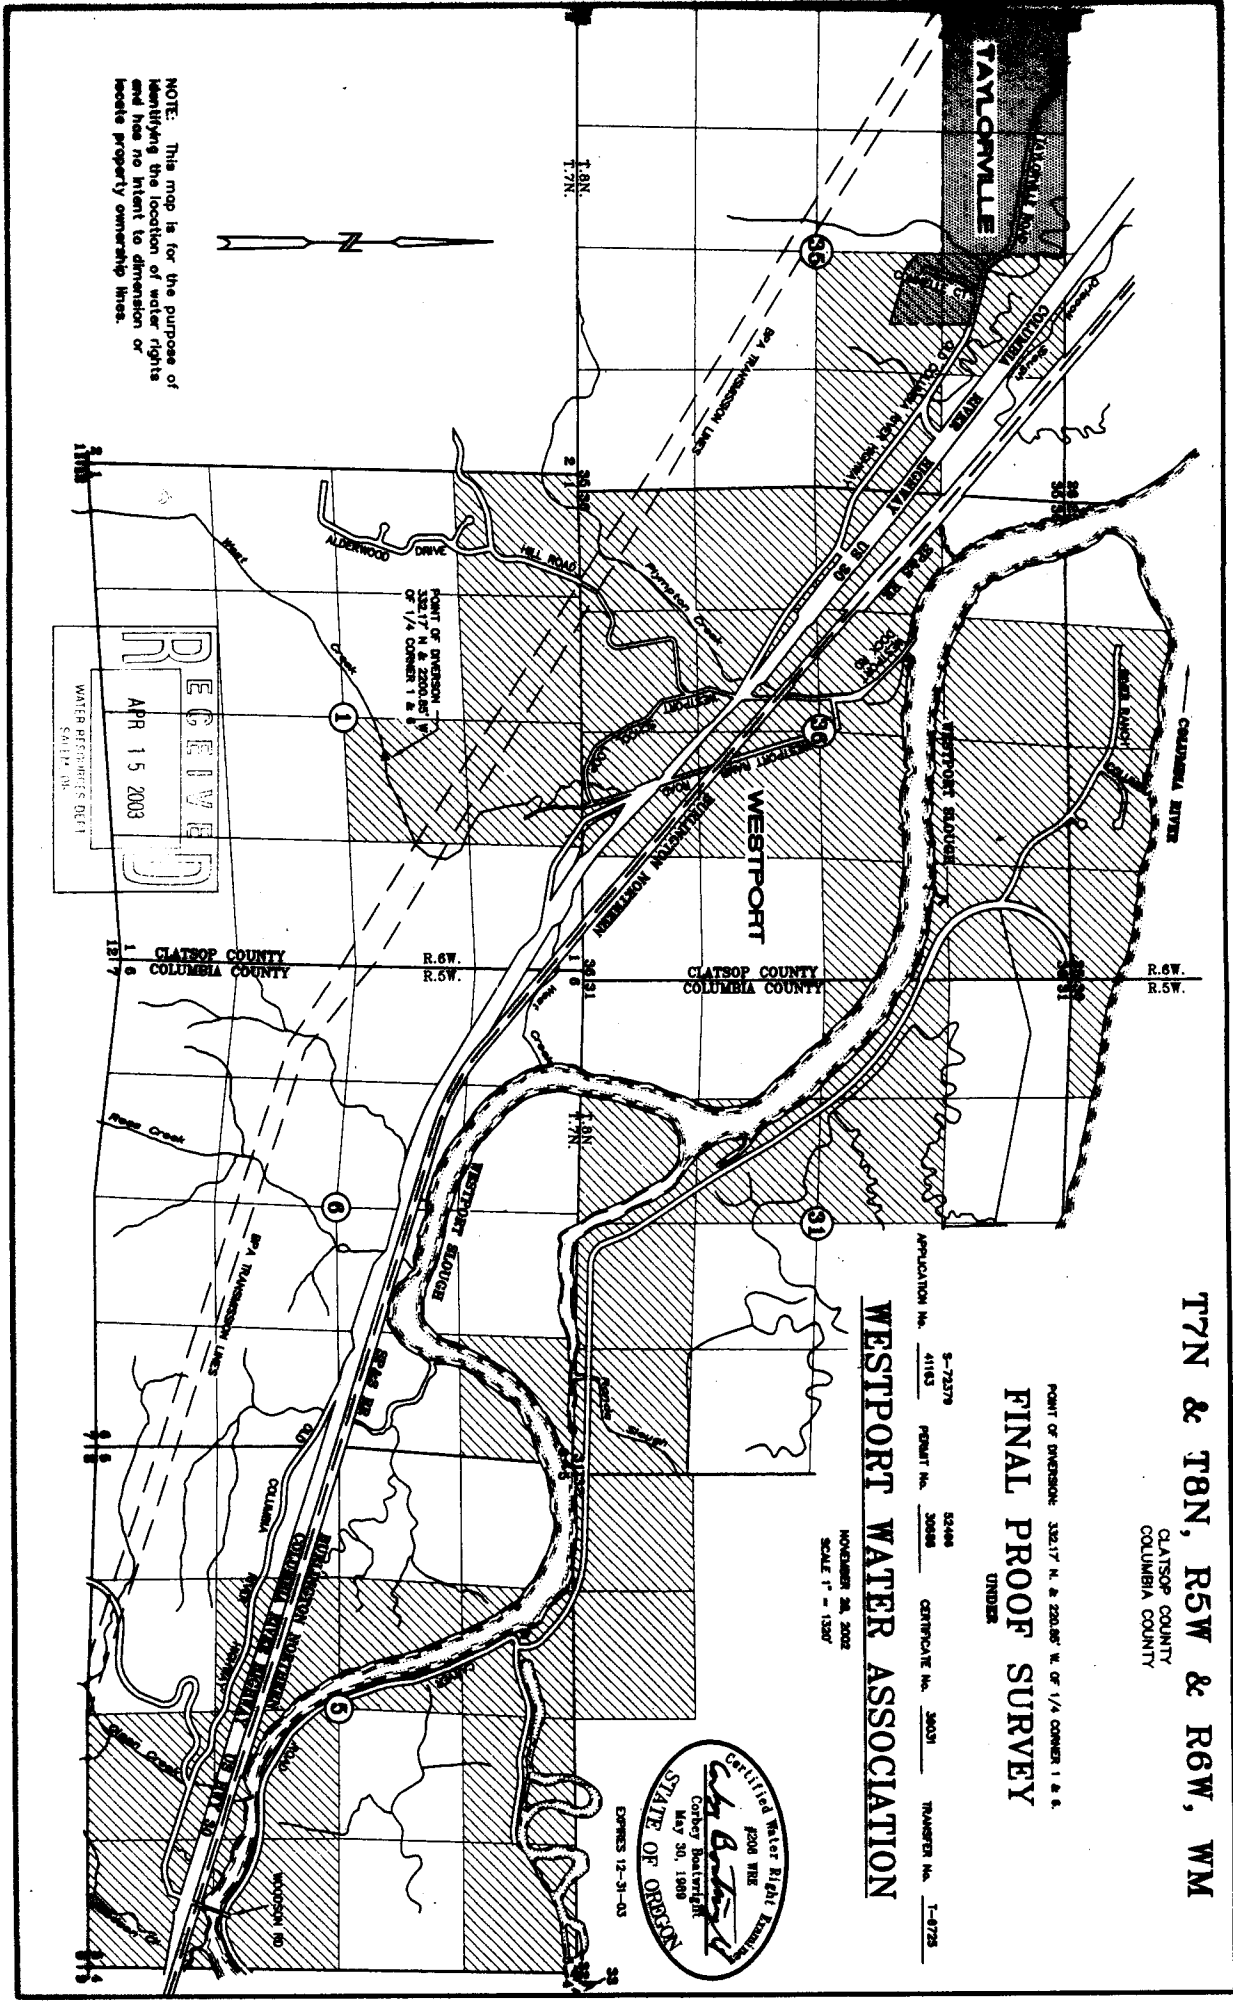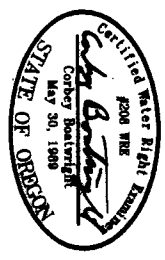

NOTE: This map is for the purpose of identifying the location of water rights and has no intent to determine or locate property ownership lines.

**RECEIVED**  
 APR 15 2003  
 WATER RESOURCES DEPT  
 SALEM, OR