
SECTION 14 T.7N. R.4W. W.M.
COLUMBIA COUNTY

THIS MAP HAS BEEN PREPARED FOR ASSESSMENT PURPOSES ONLY
Scale: 1" = 400' Current Revision Date: 3 / 9 / 90

7 4 1

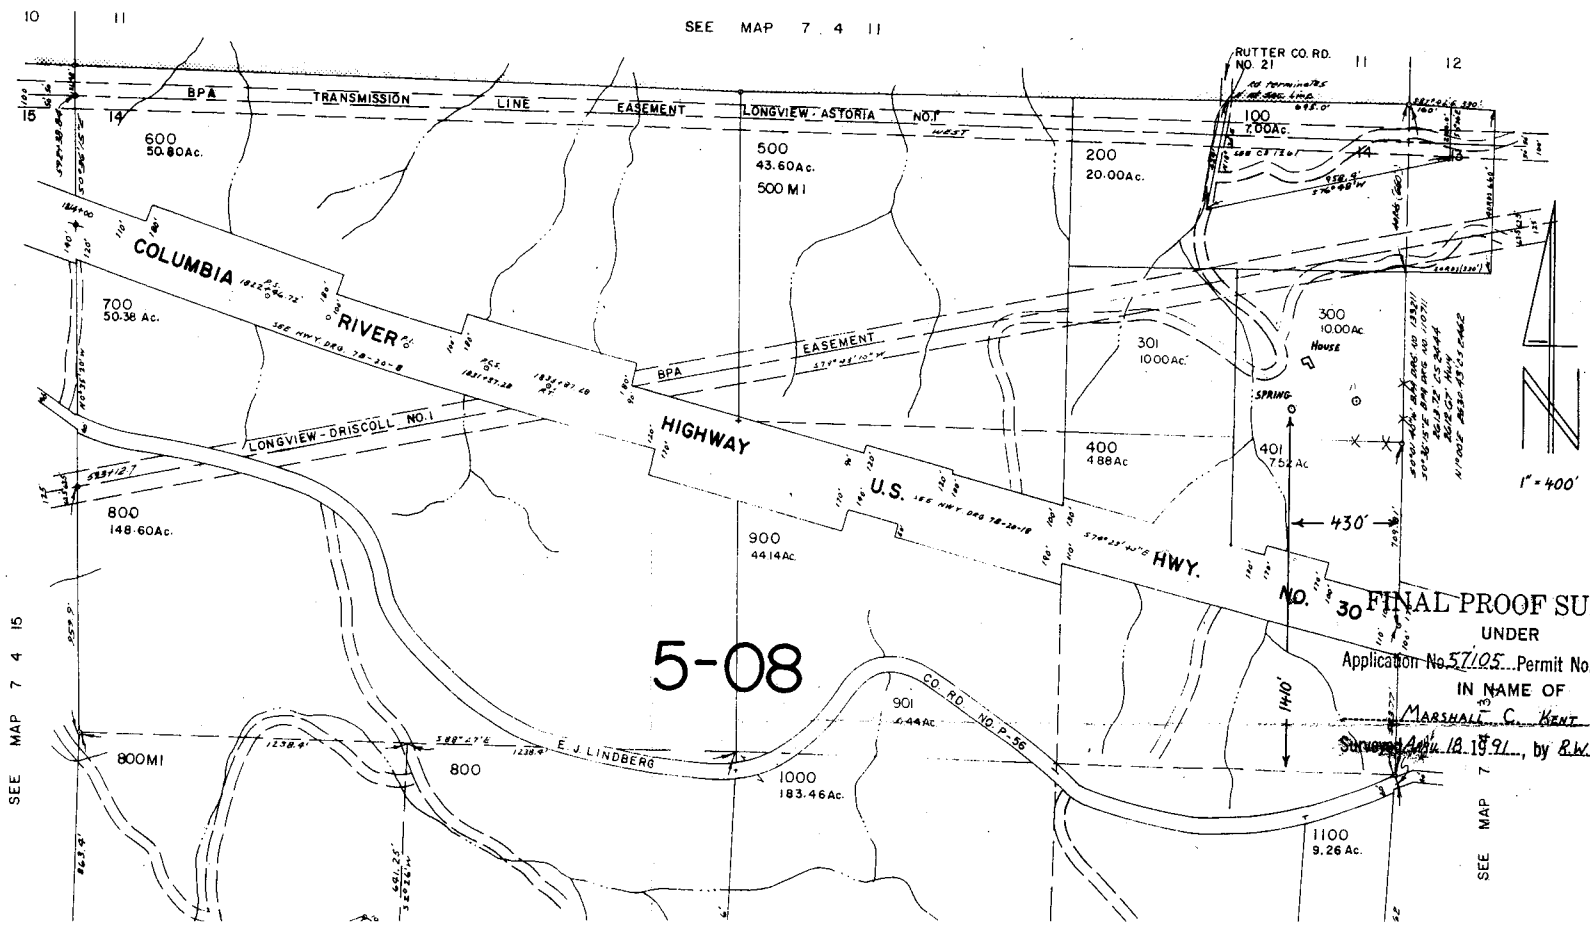

FINAL PROOF SURV.
UNDER
Application No. 57105 Permit No. 431
IN NAME OF
MARSHALL C. KENT
Surveyed Aug. 18, 1991, by R.W. Klas