
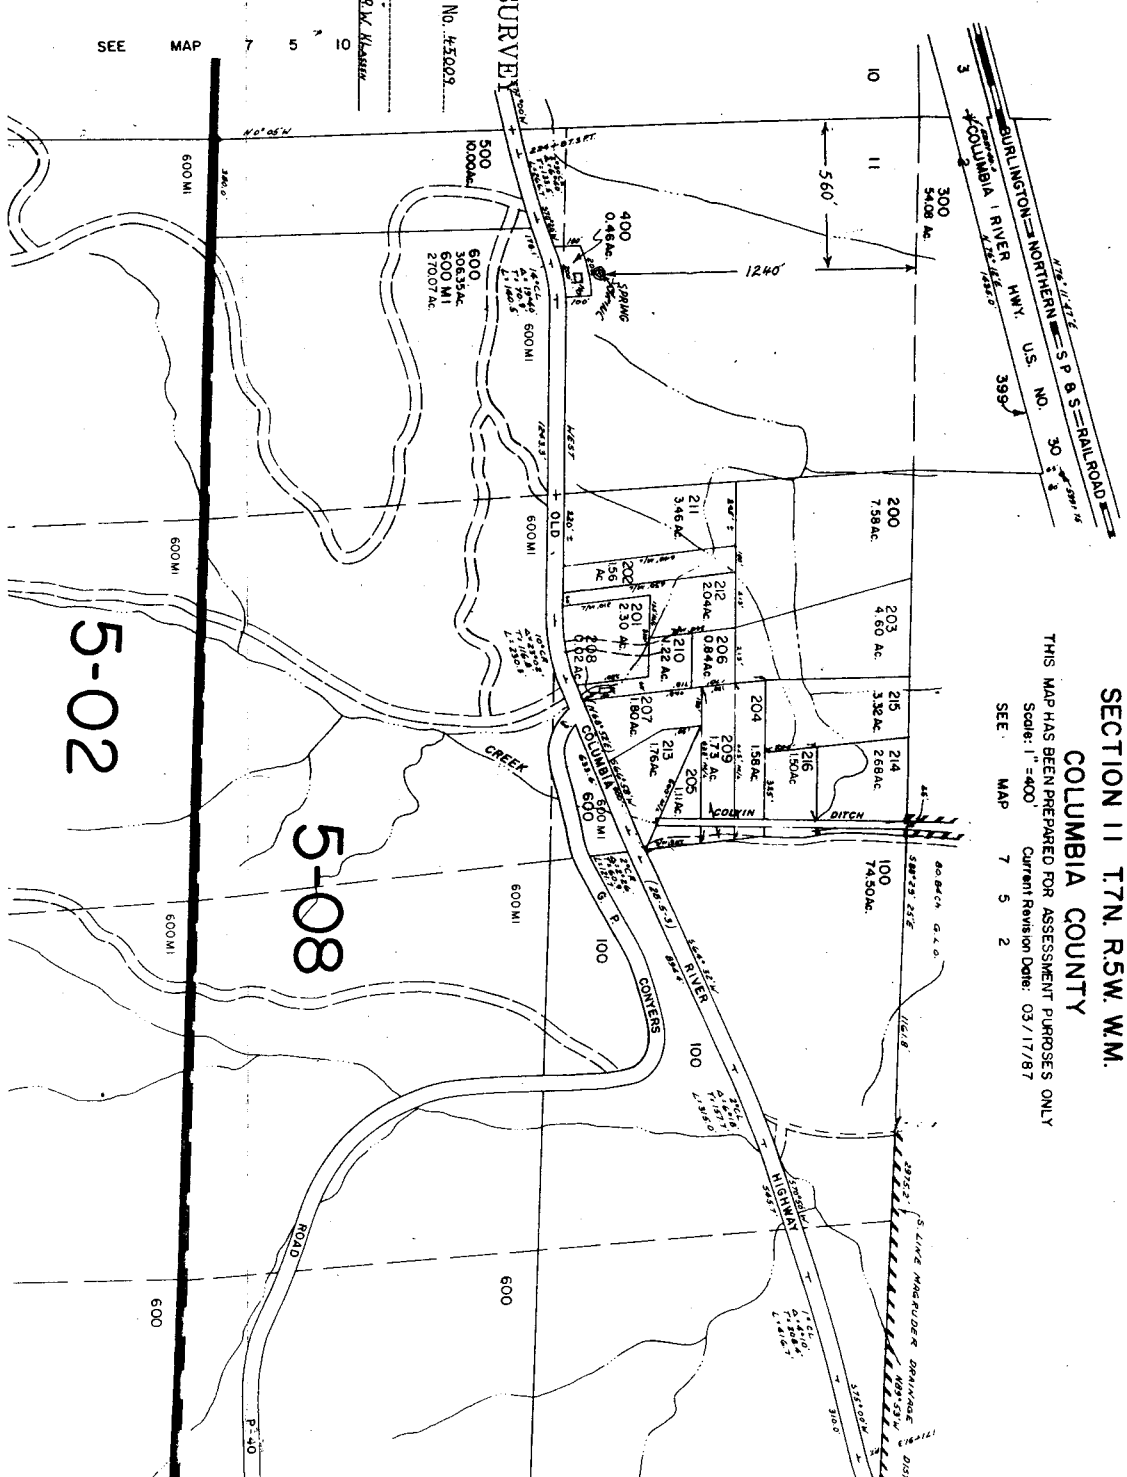


SECTION 11 T7N.R5W.W.M.
COLUMBIA COUNTY

THIS MAP HAS BEEN PREPARED FOR ASSESSMENT PURPOSES ONLY
Scale: 1"=400' CURRENT REVISION DATE: 03/17/87
SEE MAP 7 5 2

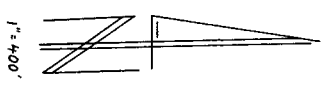

FINAL PROOF SURVEY

UNDER
Application No. 68942 Permit No. 423603
IN NAME OF

Surveyed June 18, 1971, by D. W. KASBERG

SEE MAP 7 5 2