


T. 1 S., R. 43 E., W.M.

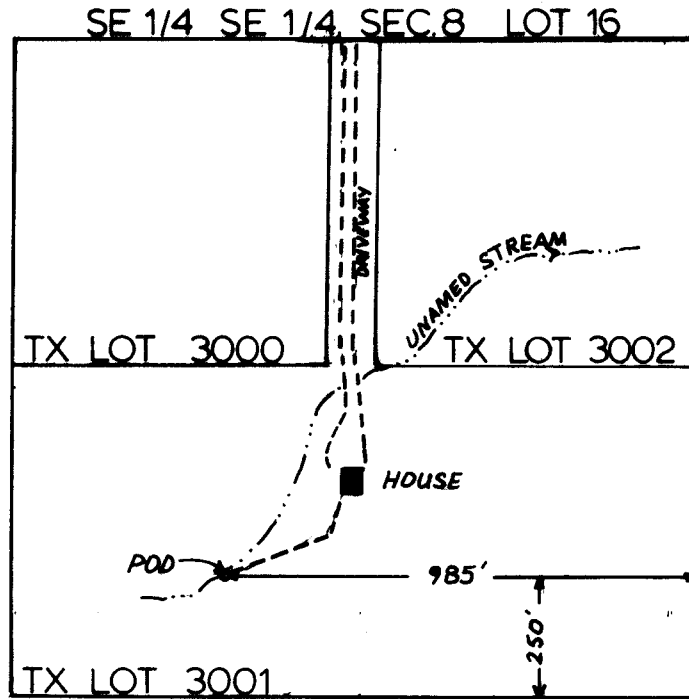

FINAL PROOF SURVEY

UNDER

Application No. 59940 Permit No. 45049

IN NAME OF

RICH E. ATTEBURY

Surveyed 10-9, 1990, by K. KEMP

RECEIVED

DEC 30 1994

WATER RESOURCES DEPT
SALEM, OREGON