


T.2N.,R.10E.,WM.

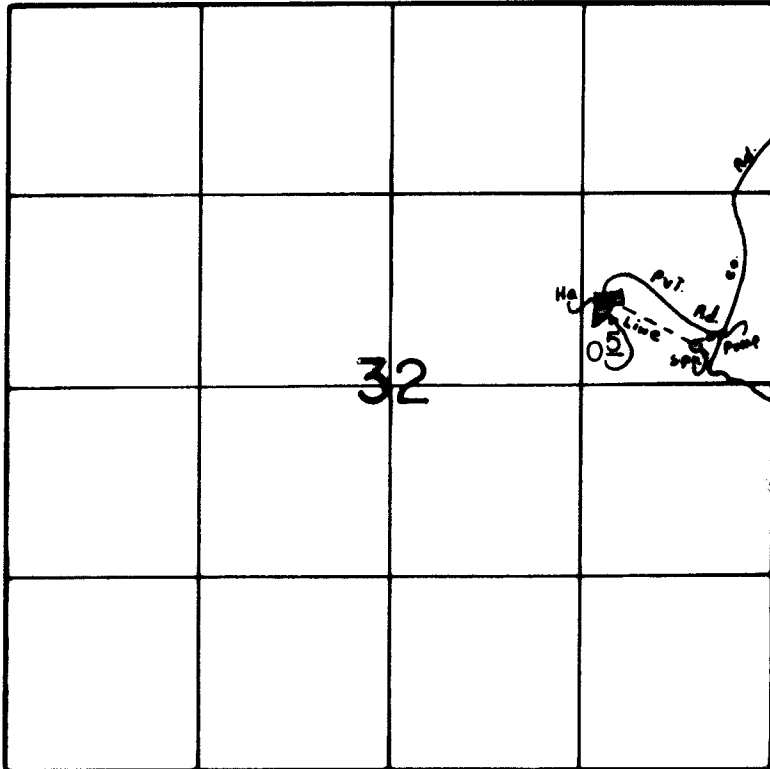

SPR. LOC: 2360' S & 540' W FROM NE COR. OF SEC 32.

SCALE: 1" = 1320'

### FINAL PROOF SURVEY UNDER

Application No. 49509 Permit No. 37357....  
IN NAME OF

SHEILA DALE & FRANK MATTSON

Surveyed AUG 17 1995, by R.M. SUTTERFIELD