


TIN, RIE, WM

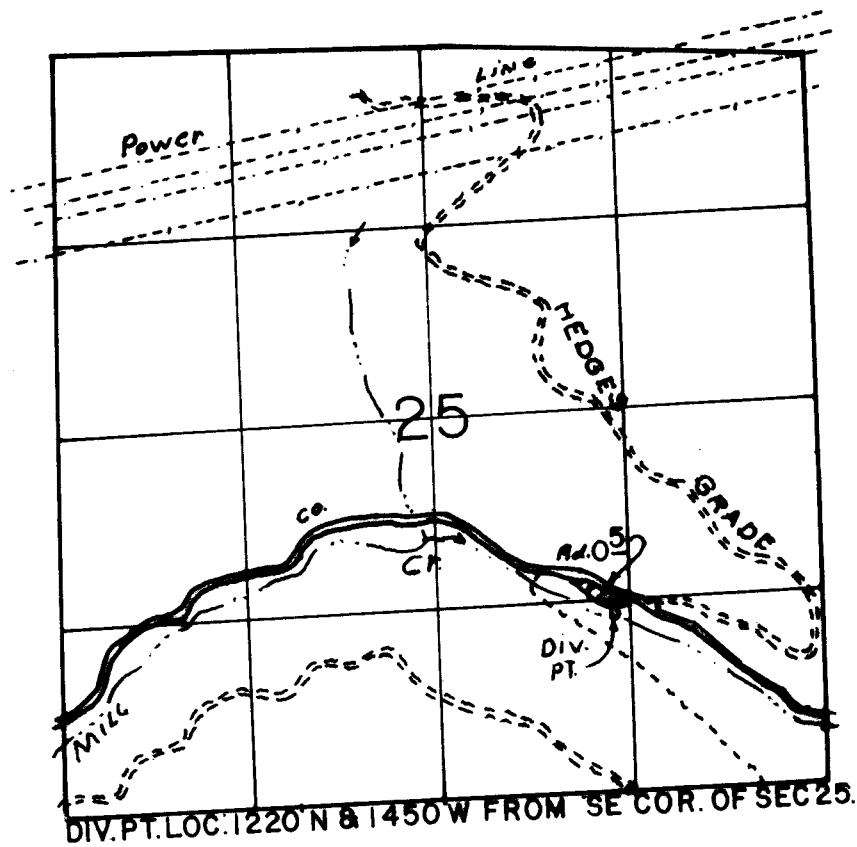

SCALE: 1" = 1320'

FINAL PROOF SURVEY UNDER

Application No. 58298 Permit No. 43969
IN NAME OF

STEVEN A. REMPEL

Surveyed MAY 17 1905, by R.M. SUTTERFIELD