


T.3S. R.45E. W.M.
SECTION 23

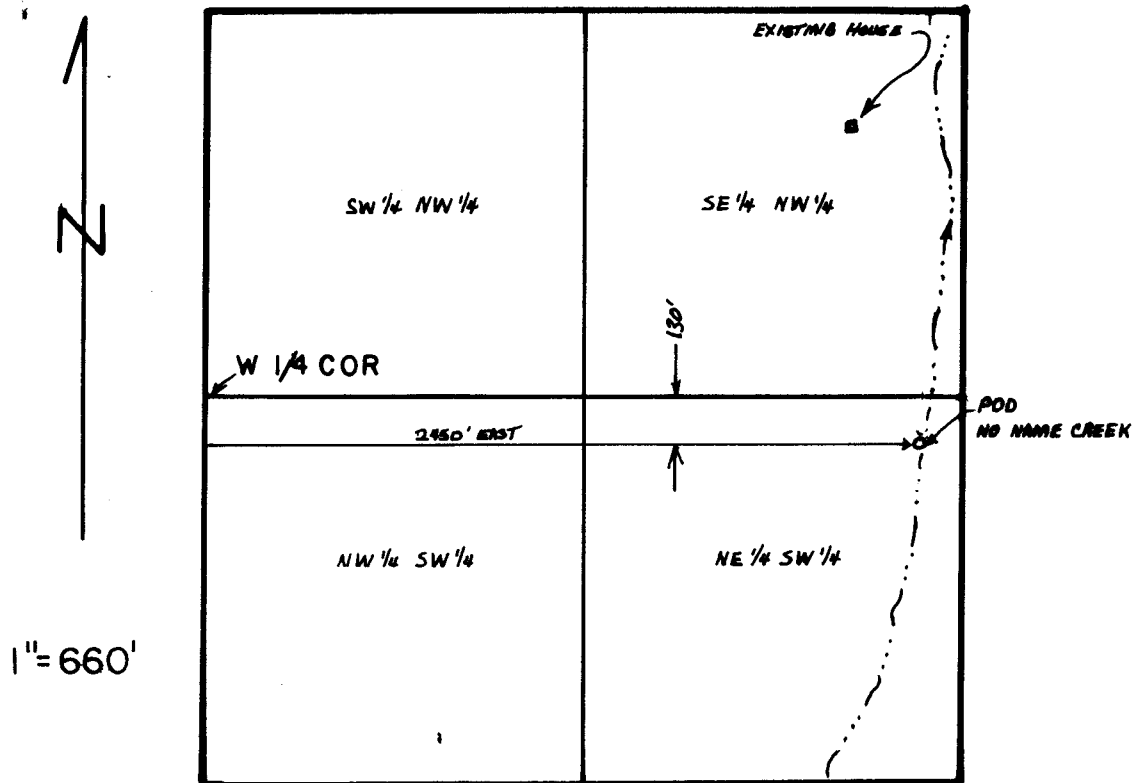

FINAL PROOF SURVEY
UNDER

Application No. 57906 Permit No. 43614....
IN NAME OF

.....ROBERT P. TRIPLETT.....

Surveyed 10-6... 1990, by K.KEMP.....

UPDATED
4-9-03
GEC

DRAFTED
2-20-92
Gunn Miller