
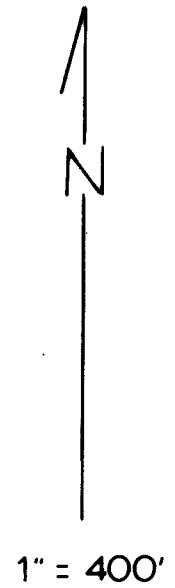


RECEIVED

SEP - 4 1997

WATER RESOURCES DEPT
SALEM OREGON

T. 4 N., R. 37 E., W.M.

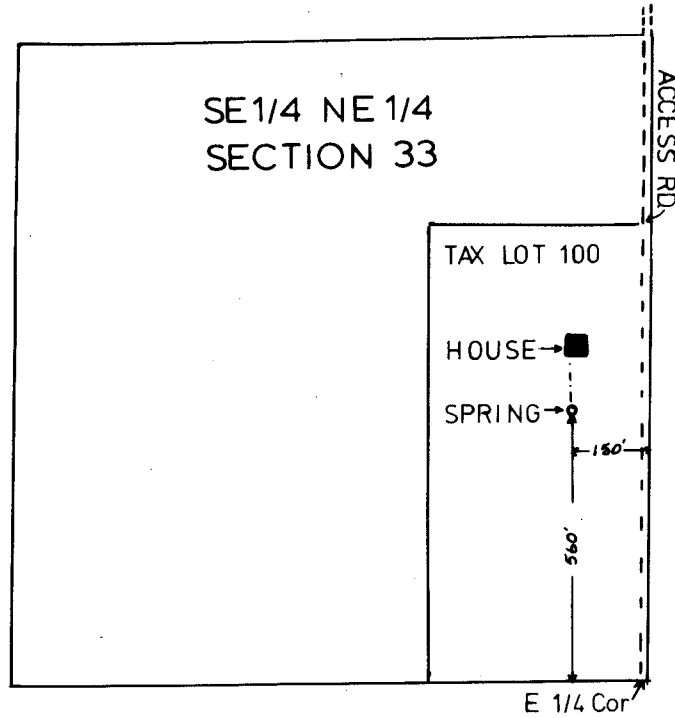

FINAL PROOF SURVEY

UNDER

Application No. 47364 Permit No. 35478

IN NAME OF

DOUGLAS J. BORTH

Surveyed June 22, 1994, by J. Miller