


T. 27 S., R. 14 W. W.M.

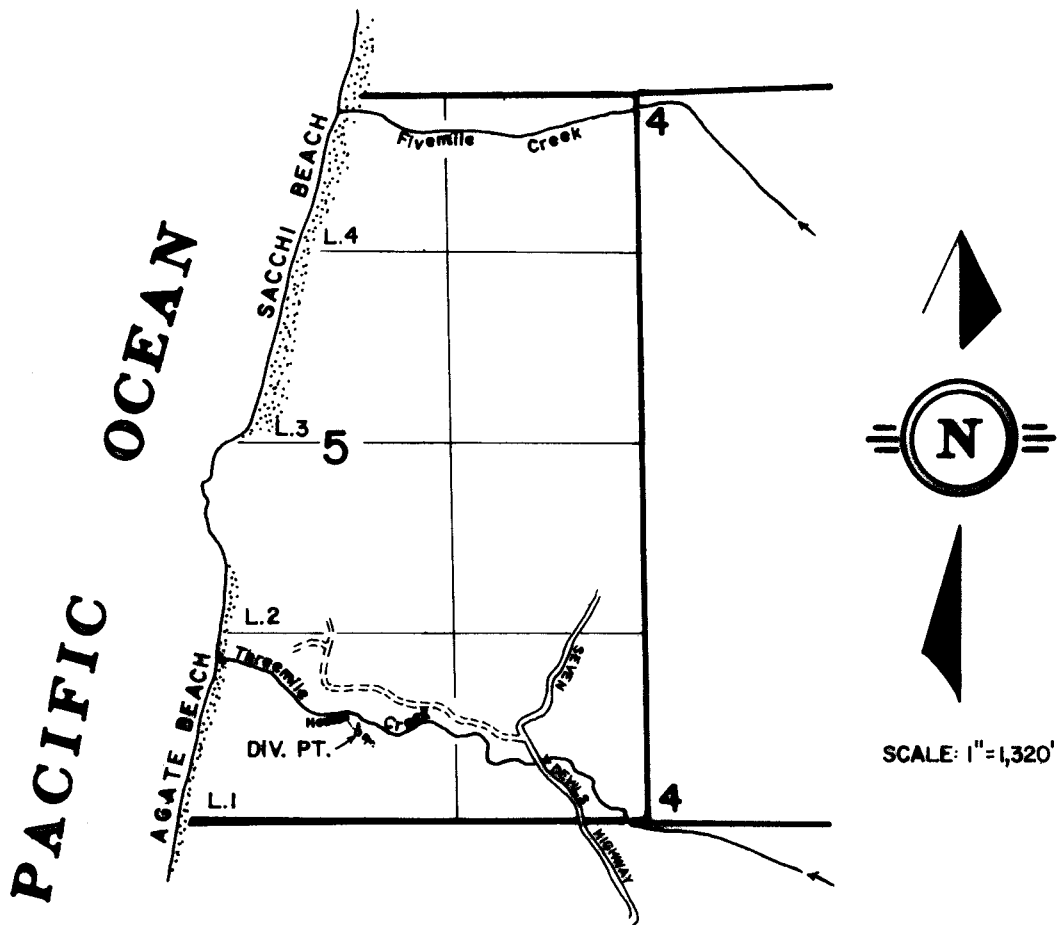

DIV. PT. LOCATION : 600' NORTH and 2,000' WEST
FROM THE SOUTHEAST CORNER of SECTION 5.

FINAL PROOF SURVEY UNDER

Application No. 52068 Permit No. 39238.....
IN NAME OF

...CLARENCE Van De CAMP.....

Surveyed ..Sept.13 1920, by .M..Schmorda...