


T.2S., R.5W., W.M.

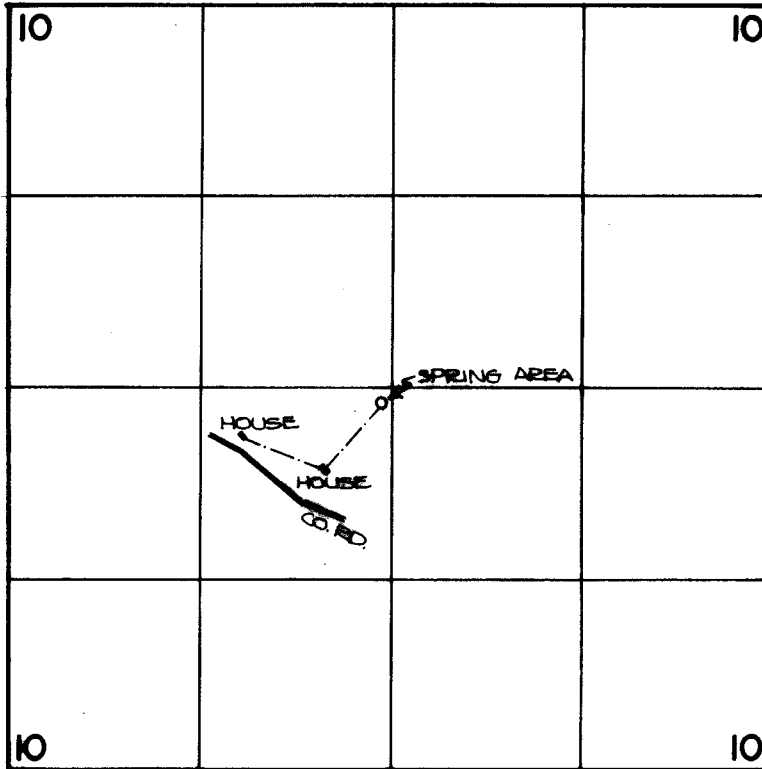

SPRING AREA LOCATION: 100 FT. S AND 70 FT. W FROM
THE CENTER OF SECTION 10.

FINAL PROOF SURVEY UNDER



1" = 1320'

Application No. 53950 Permit No. 40244
IN NAME OF

DARRELL & SHARON McCULLOCH

Surveyed JUNE 9, 1993, by R.W. KLASSEN