


TOWNSHIP 14 SOUTH, RANGE 30 EAST, W. M.

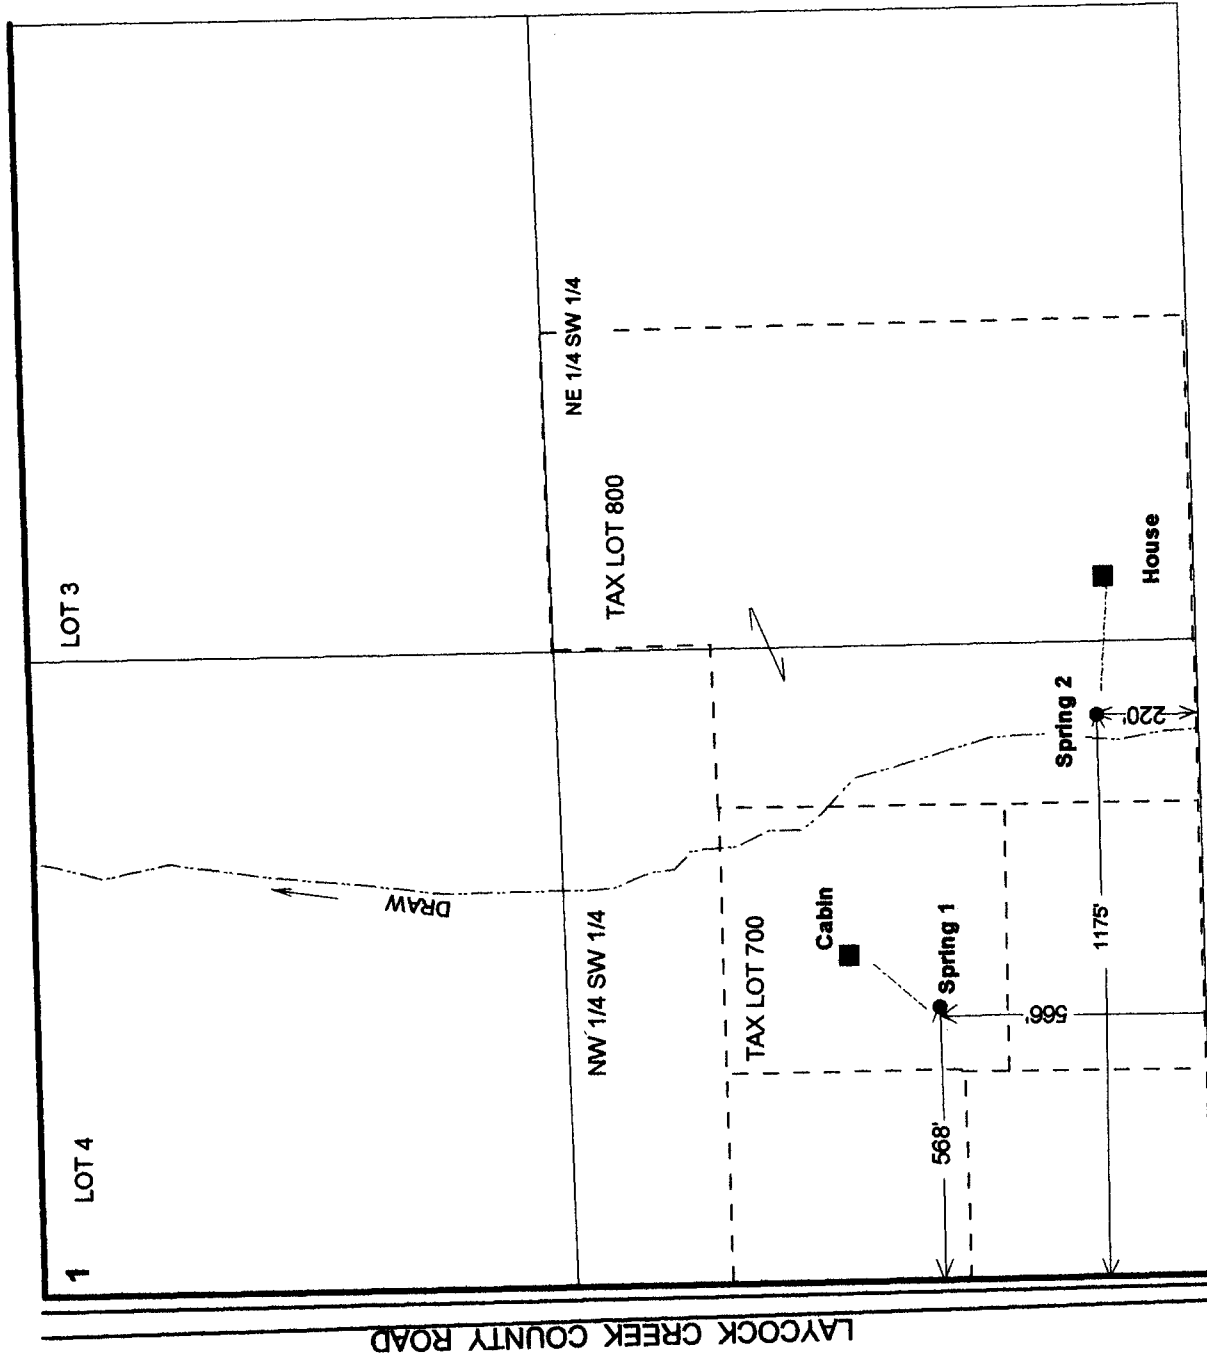

FINAL PROOF SURVEY

UNDER

Application No. 54392 Permit No. 40761

IN THE NAME OF

Surveyed June 12, 2001 by J. Miller

RECEIVED

DEC 02 2002

WATER RESOURCES DEPT.
SALEM, OREGON