


T.IIS., R.40E., W.M.

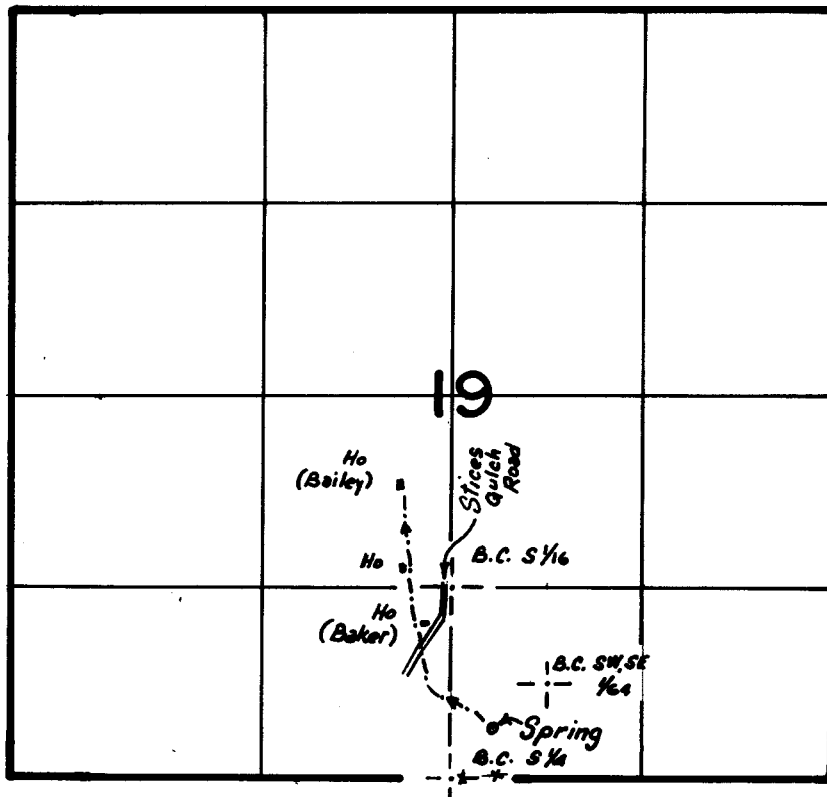

The location of the spring is 350' N. & 300' E.
from the S 1/4 cor. sec. 19.



Scale: 1" = 1320'

FINAL PROOF SURVEY
UNDER

Application No. 54848 Permit No. 41144
IN NAME OF

T.L. & K.K. BAILEY, LL. & M.S. BAILEY, MR. & MRS. T. BAKER

Surveyed 8-23 1988, by Vern Church

P.T.S. KK