
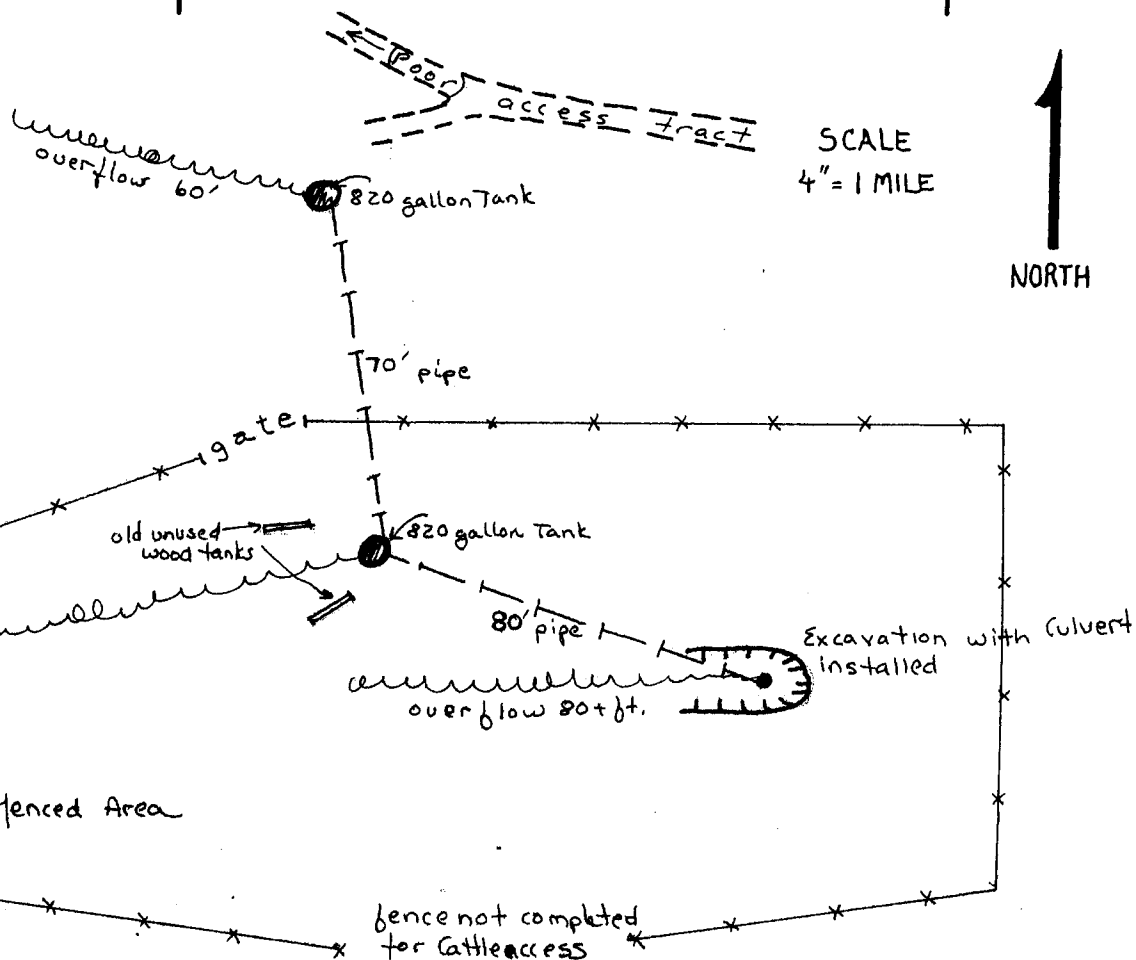



ROUBLE SPRING
T.13 S., R.13 E., Sec 23
SE, NW

RECEIVED
SEP 19 1983
WATER RESOURCES DEPT.
SALEM, OREGON

Application No. 66380
Permit No. 52352

SPRING SKETCH
1" = 40'

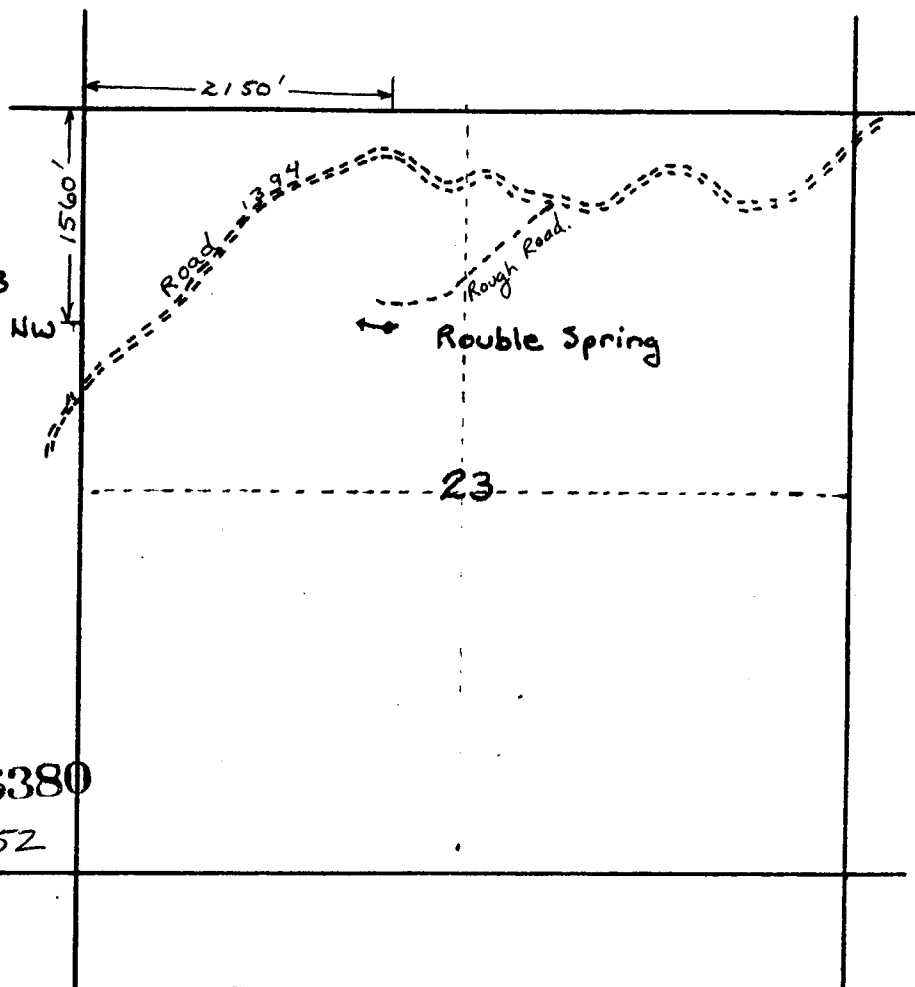

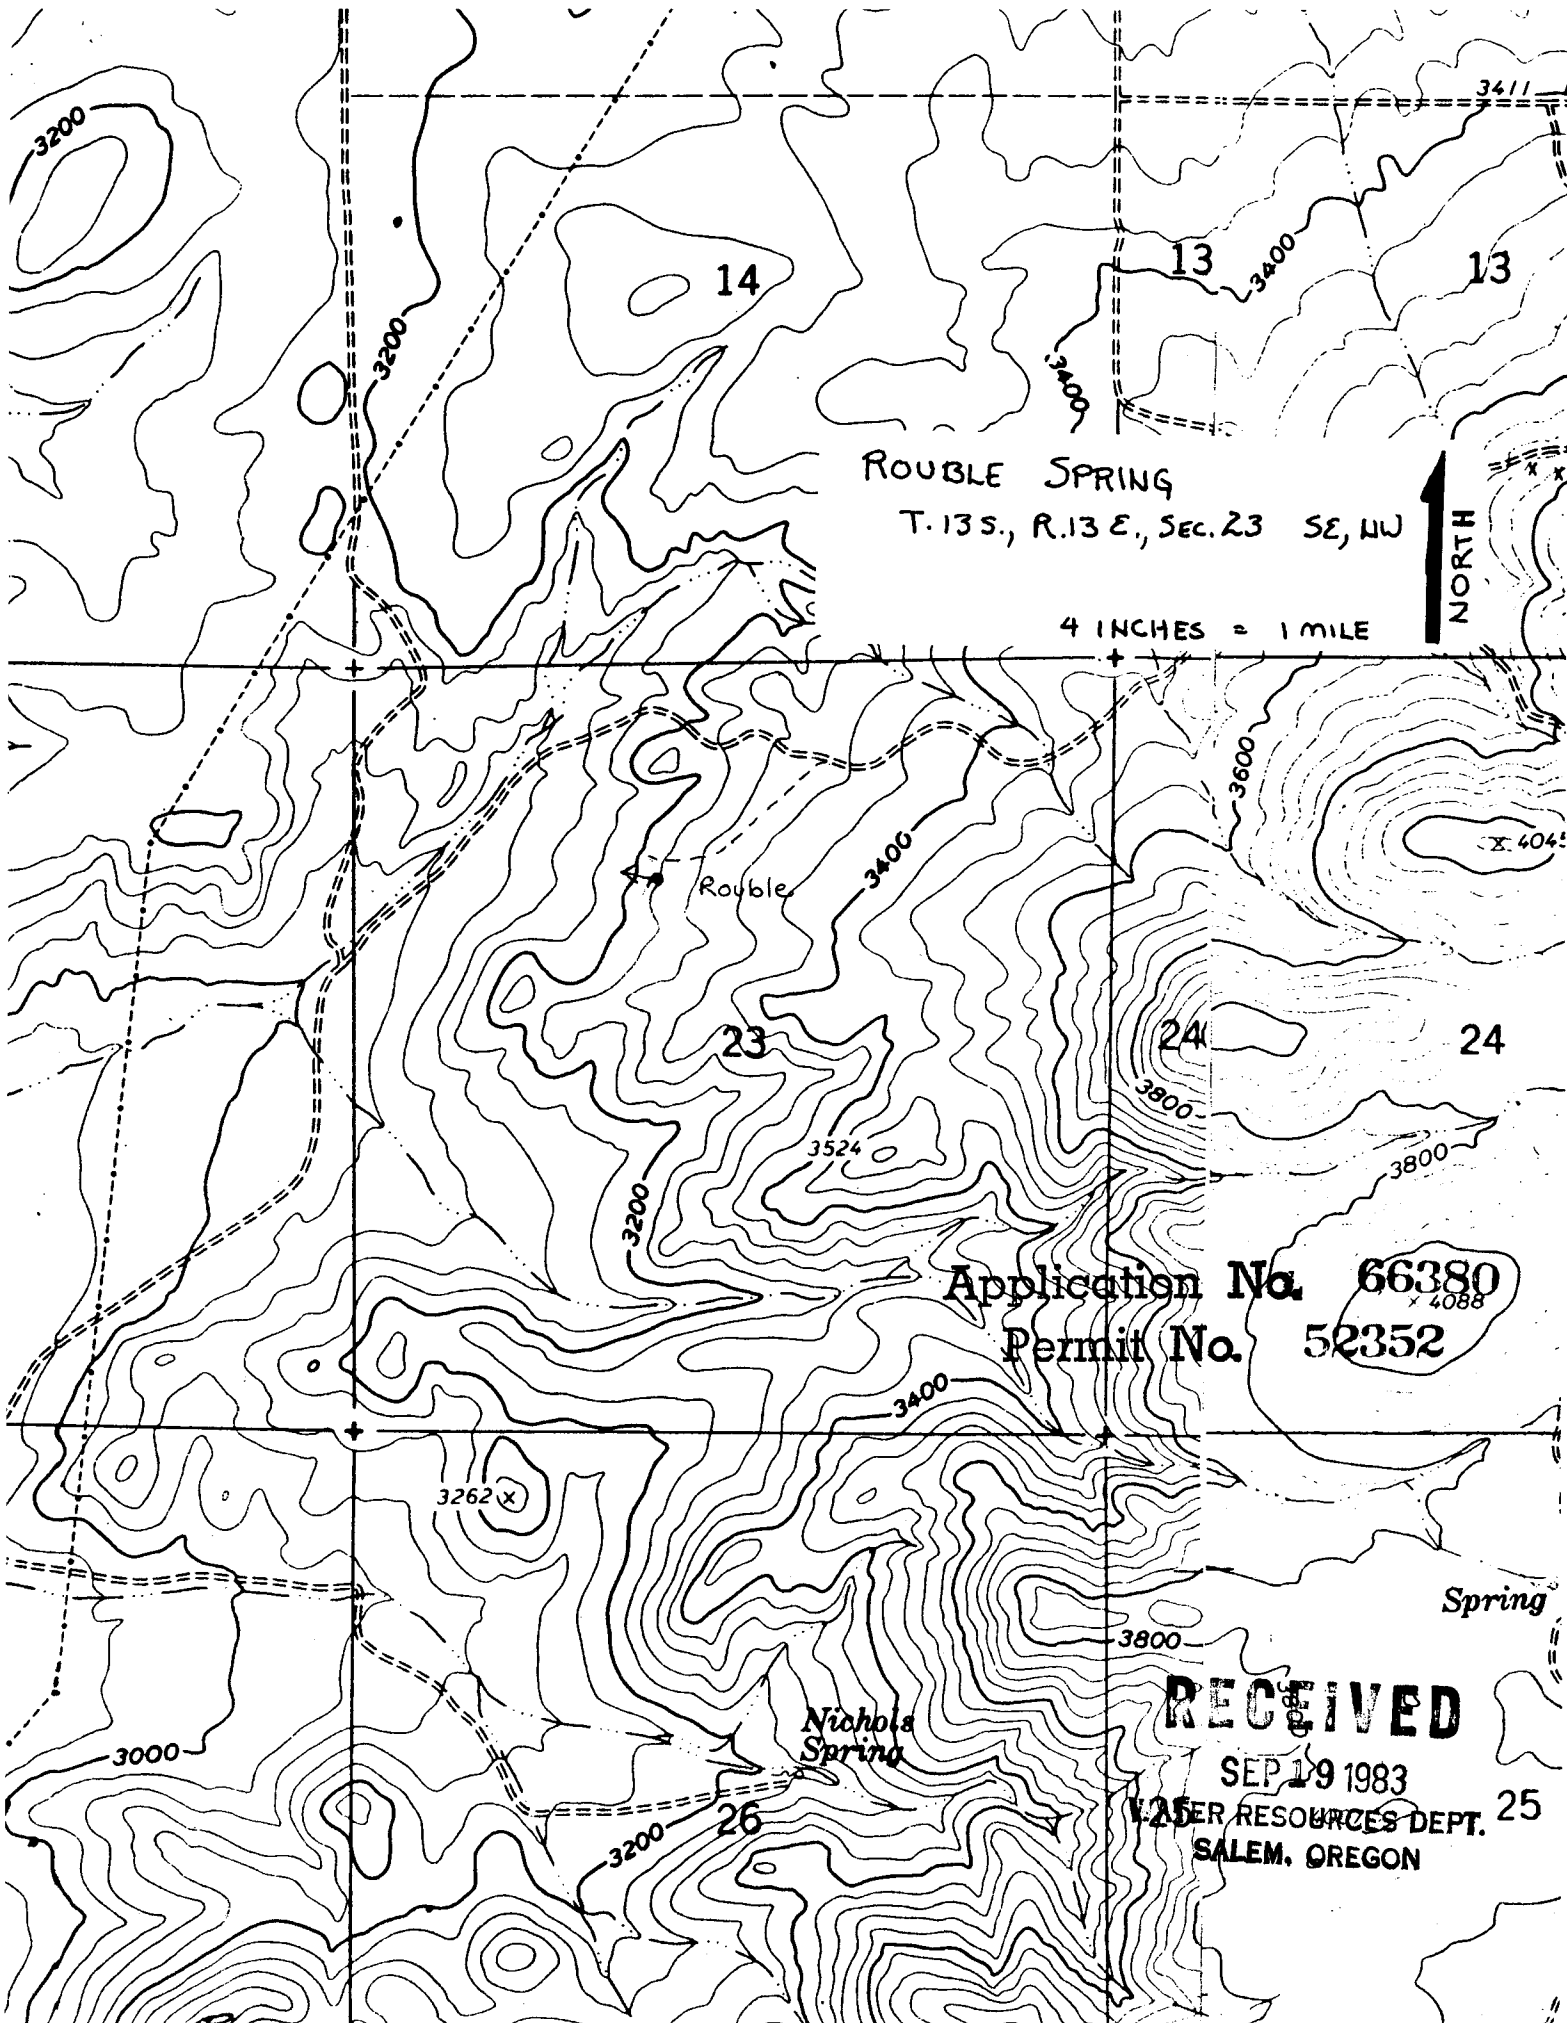

ROUBLE SPRING

T. 13 S., R. 13 E., SEC. 23 SE, NW

4 INCHES = 1 MILE

NORTH

Application No. 66380
Permit No. 52352

RECEIVED

SEP 19 1983

WATER RESOURCES DEPT.
SALEM, OREGON

25