


T. 20S., R. 12 W., W. M.

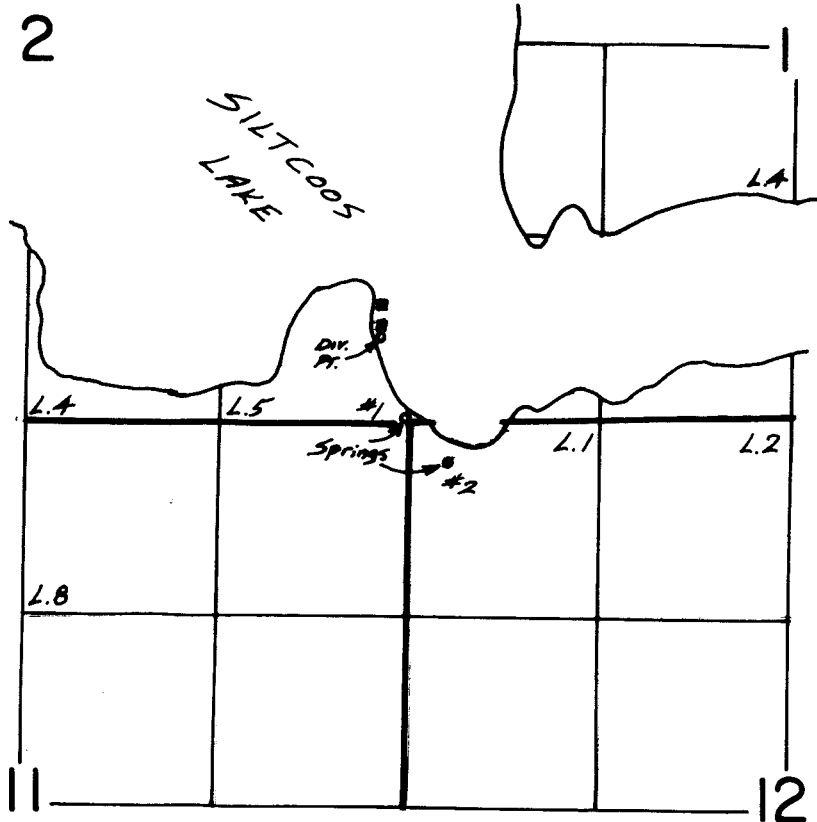

Spring 1: 30' NORTH & 40' WEST FROM SE COR.
OF SECTION 2.

Spring 2: 250' SOUTH & 250' EAST FROM NW COR.
OF SECTION 12.

Div. Pt.: 560' NORTH & 180' WEST FROM SE COR.

Scale 1" = 1320'

FINAL PROOF SURVEY
UNDER

Application No. 5.8.982 Permit No. 44.654....
IN NAME OF

.....MYLER, M. BEERY.....

Surveyed Sept. 15, 1994., by B.S. DeHaas.....