


T. 35 S., R. 11 W., W. M.

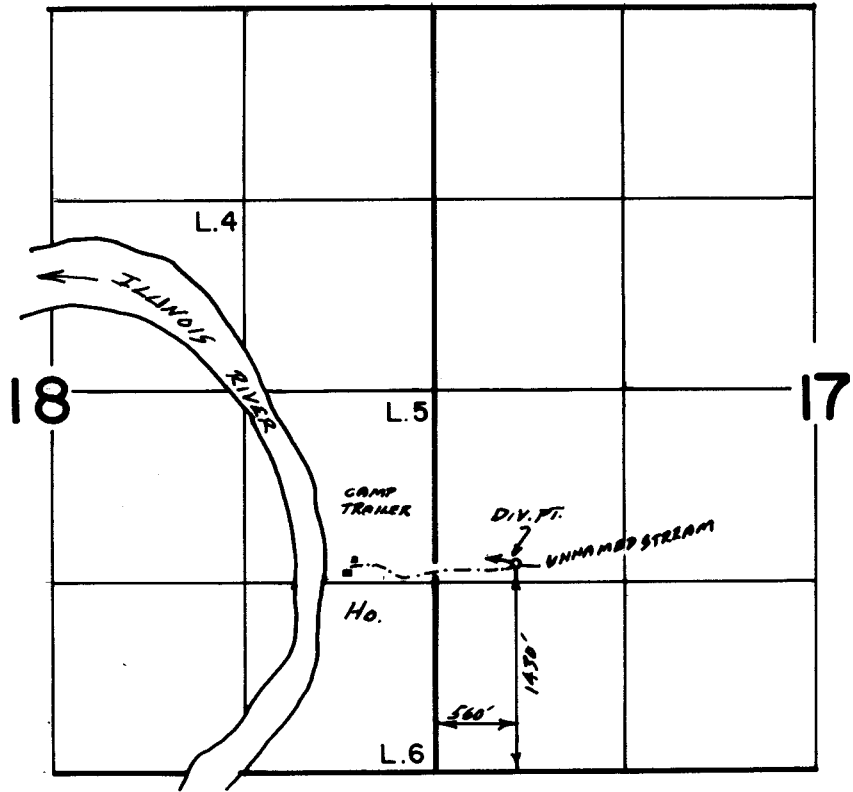

Scale : 1" = 1320'

**FINAL PROOF SURVEY**  
**UNDER**

Application No. 592.85 Permit No. 45302...  
IN NAME OF

..MR. & MRS. DENNIS GRAVES..

Surveyed July 30, 1989, by B.S. JAMES.....