


T. 15 S., R. 12 W., W.M.

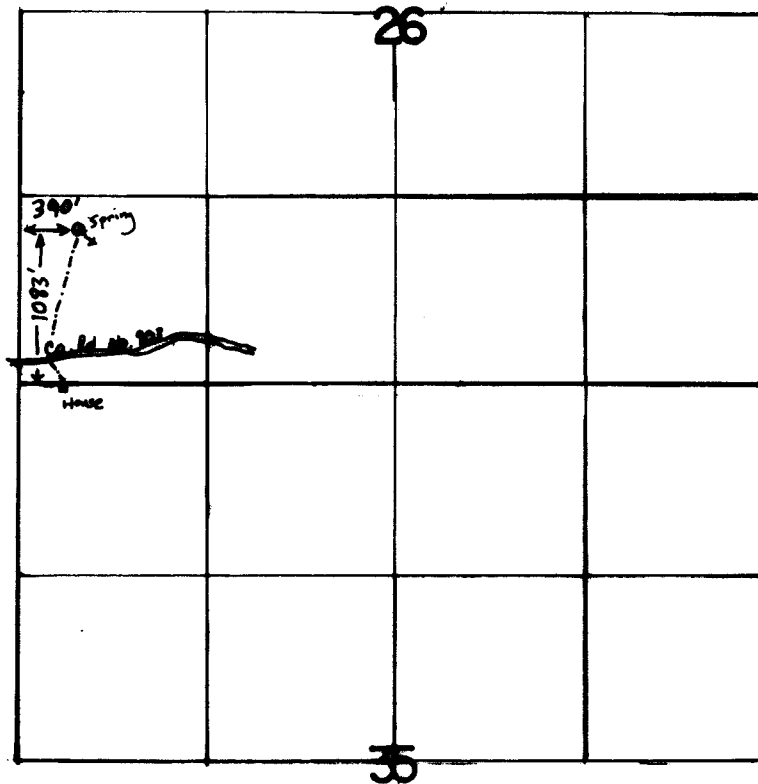

FINAL PROOF SURVEY

UNDER

Application No. 62044 Permit No. 46137
IN NAME OF

ROBERT S. VAN NOTE & DOROTHY M. SMITH

Surveyed NOVEMBER 16, 1992, by R.W. KLASSEN

GEC 5/9/03

KC 3/93

DBQ 17K 76