


T. 20S., R. 12 W., W.M.

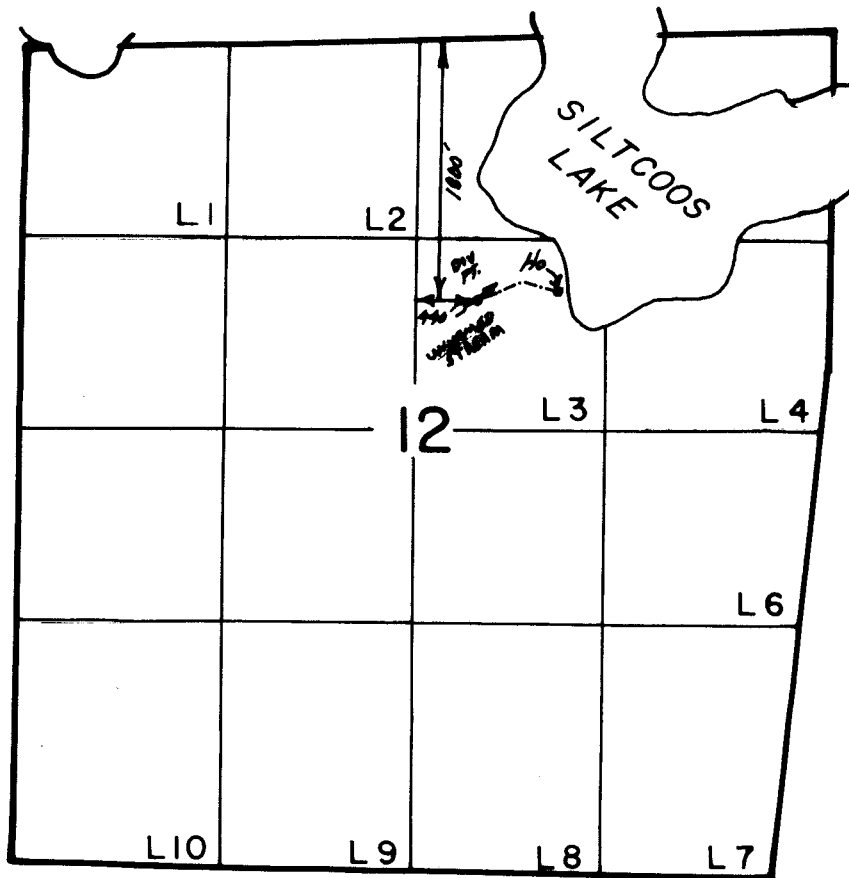

SCALE 1" = 1320'

**FINAL PROOF SURVEY
UNDER**

Application No. 61076. Permit No. 46123.....
IN NAME OF

BOBBY J. & DORIS A. GARRETT.....

Surveyed Sept. 26, 1994., by B.S. DeHaas.....