


T.7 S., R 24 E., W.M.

RECEIVED

MAR 02 2001

WATER RESOURCES DEPT.
SALEM, OREGON

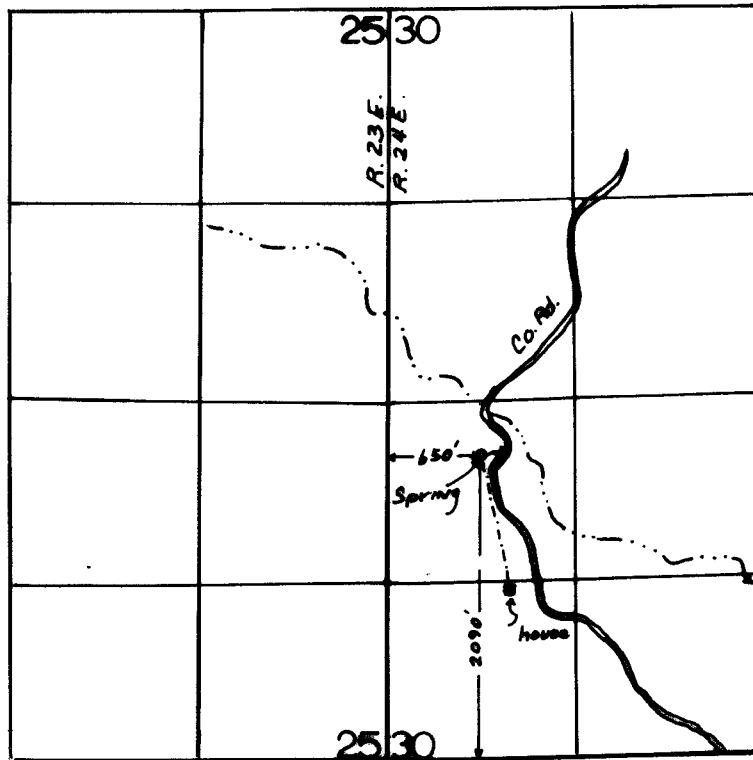

1" = 1320'

FINAL PROOF SURVEY
UNDER

Application No. 61937... Permit No. 46276.....
IN NAME OF

.....CALVIN G. BOYD.....

Surveyed 6-9..... 2000., byJ. MILLER.....