


T. 1 N., R 43 E., W. M.

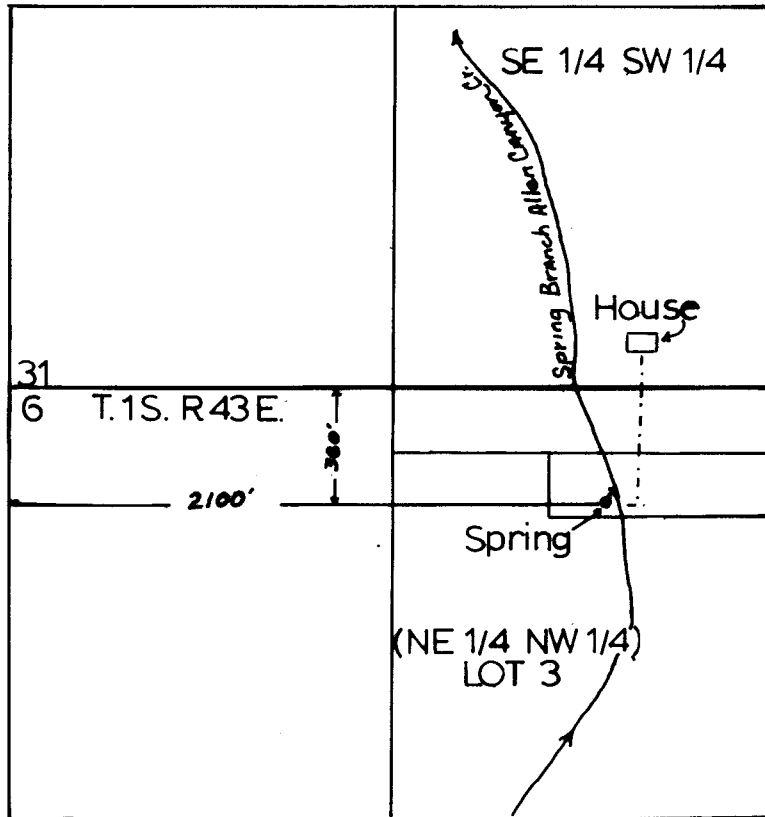

FINAL PROOF SURVEY
UNDER

Application No. 63062... Permit No. 46865...
IN NAME OF

SPS...ENTERPRISES...OF...OREGON...INC.

Surveyed 7-13... 1994, by J. Miller.....