


SECTION 12 T7N. R5W. WM.

COLUMBIA COUNTY

1" = 400'

SEE MAP 7 5 1

7 5 12

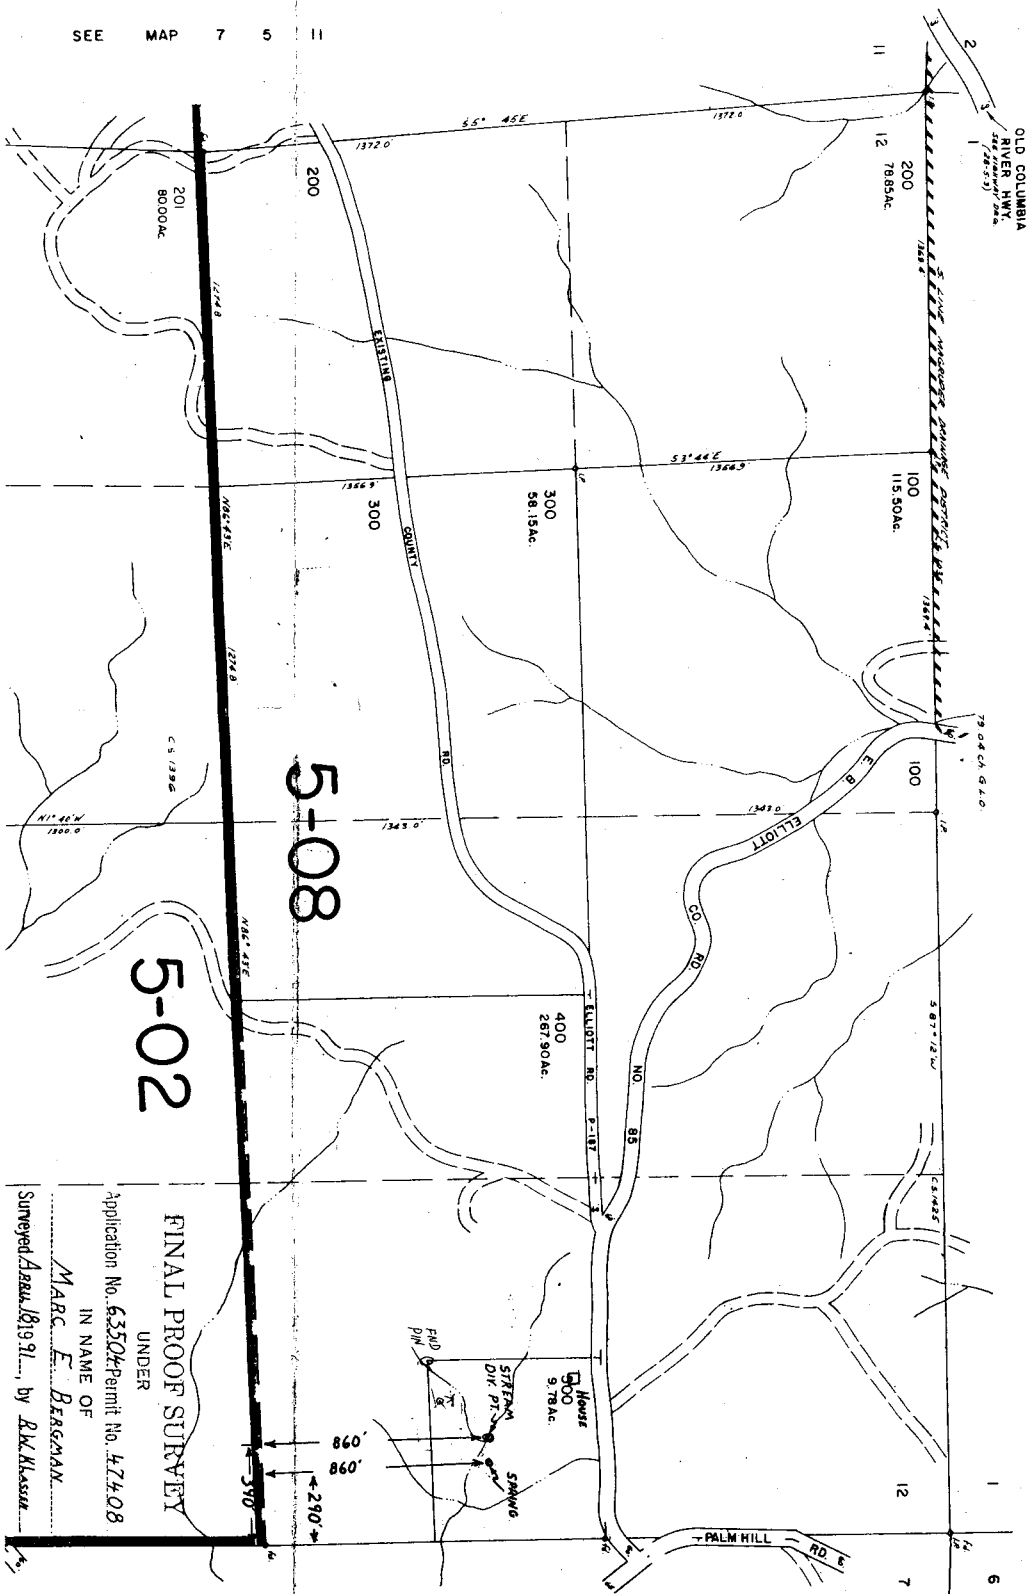

SEE MAP 7 5 11