


T.11S. R.20E., W.M.

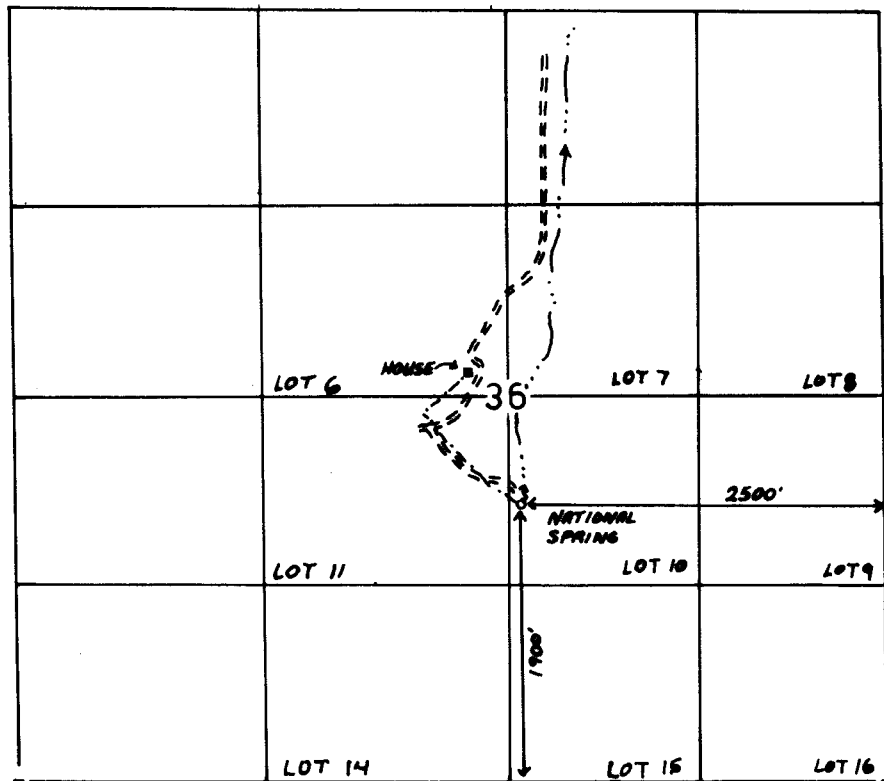

**FINAL PROOF SURVEY
UNDER**

Application No. 63803.. Permit No. 47631.....
IN NAME OF

.....DAVID F. & LINDA GORTON.....

Surveyed...11-12... 19.90., by K.KEMP.....