


T. 1 N., R. 5 E., W.M.

SECTION 14

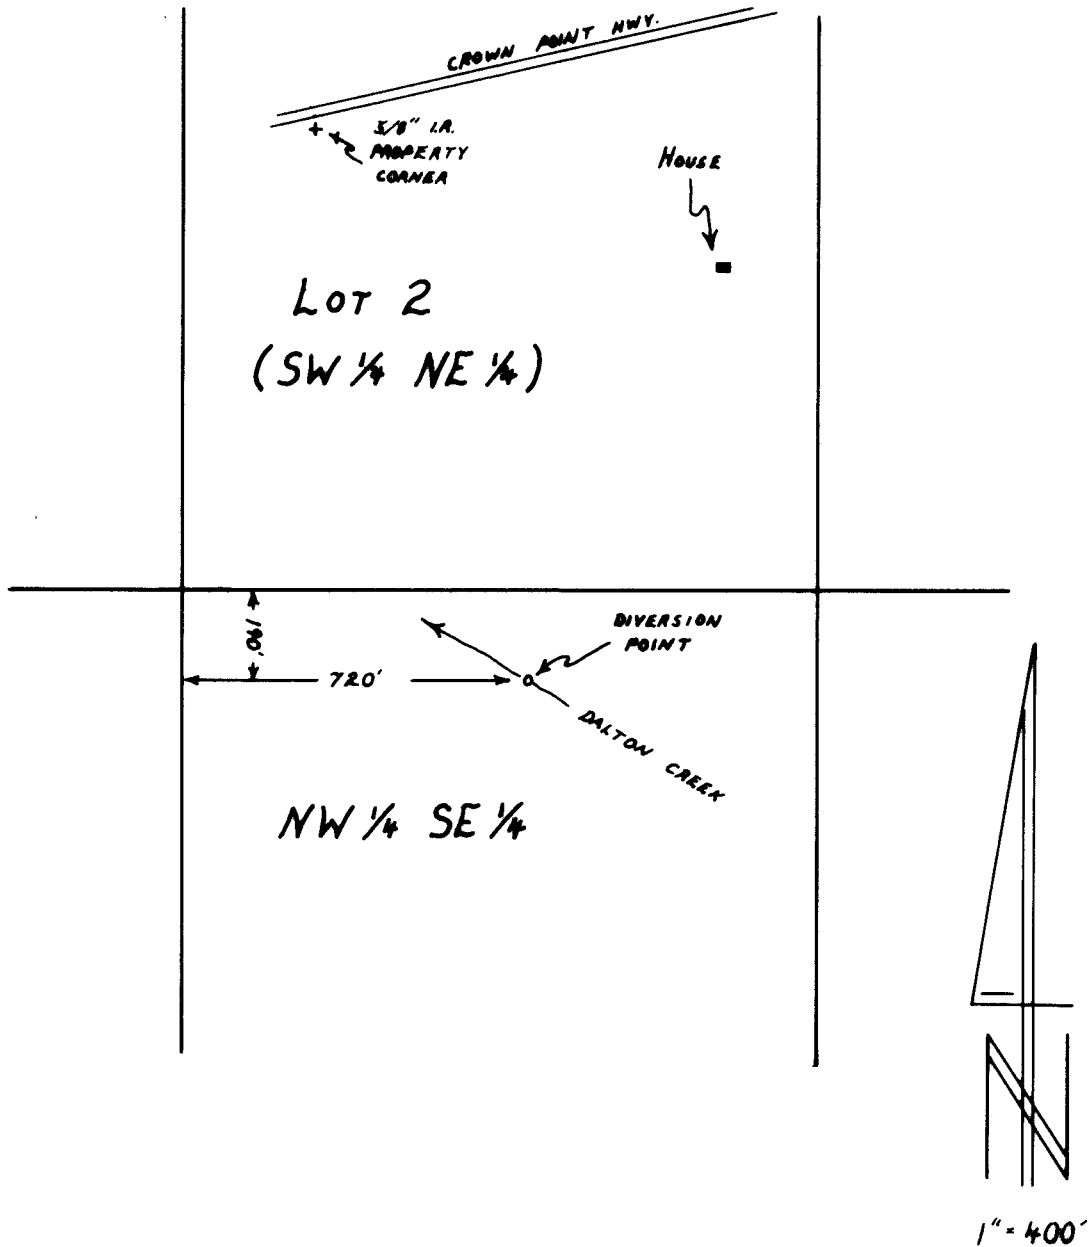

FINAL PROOF SURVEY

UNDER

Application No. 68312 Permit No. 49278
IN NAME OF

John A. Backstrand

Surveyed April 27, 1994, by R.W. Klassen