


SCALE
4" = 1 mile

NORTH

Black Spring
T. 13 S., R. 13 E.,
Section 14, SE, SE.

Application No. 66381
Permit No. 52351

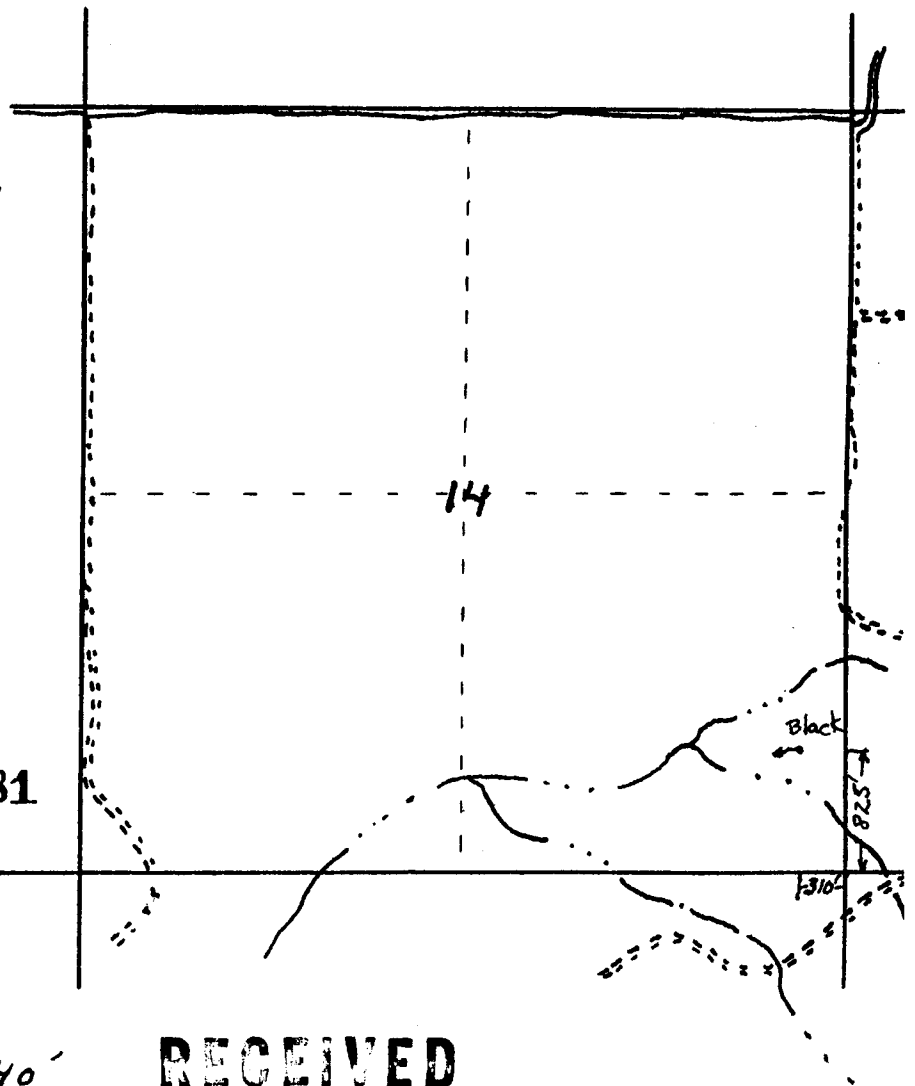

↑ diagram: 1" = 40'

RECEIVED

SEP 19 1983

WATER RESOURCES DEPT.
SALEM, OREGON

