
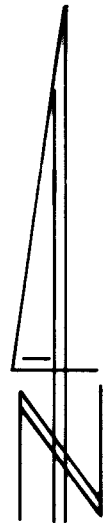


T. 4 N., R. 7 W., W.M.

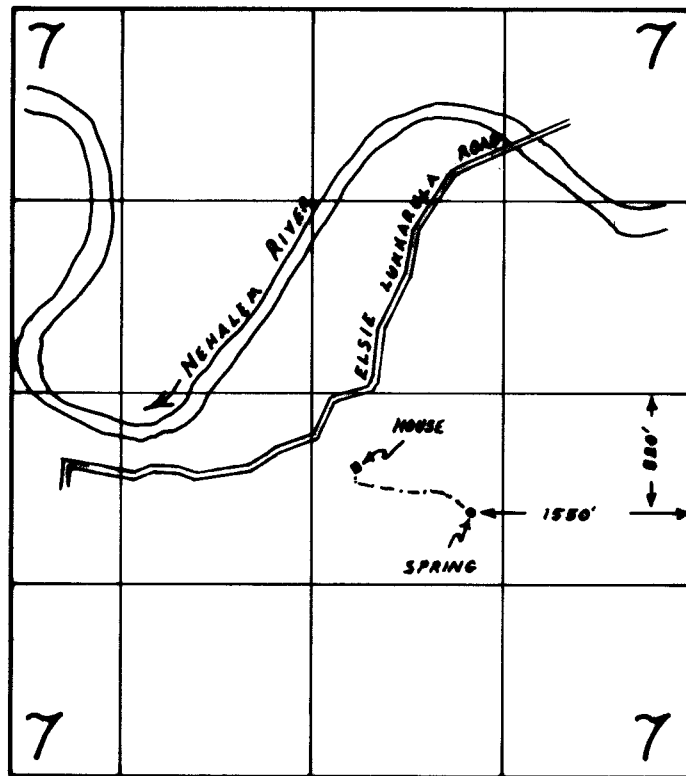

1"=1320'

FINAL PROOF SURVEY

UNDER

Application No. 65047 Permit No. 47566
IN NAME OF

Beatrice J. Borden

Surveyed November 30, 1993, by R.W. Klassen