


T. 2 S., R. 27 E., W.M.

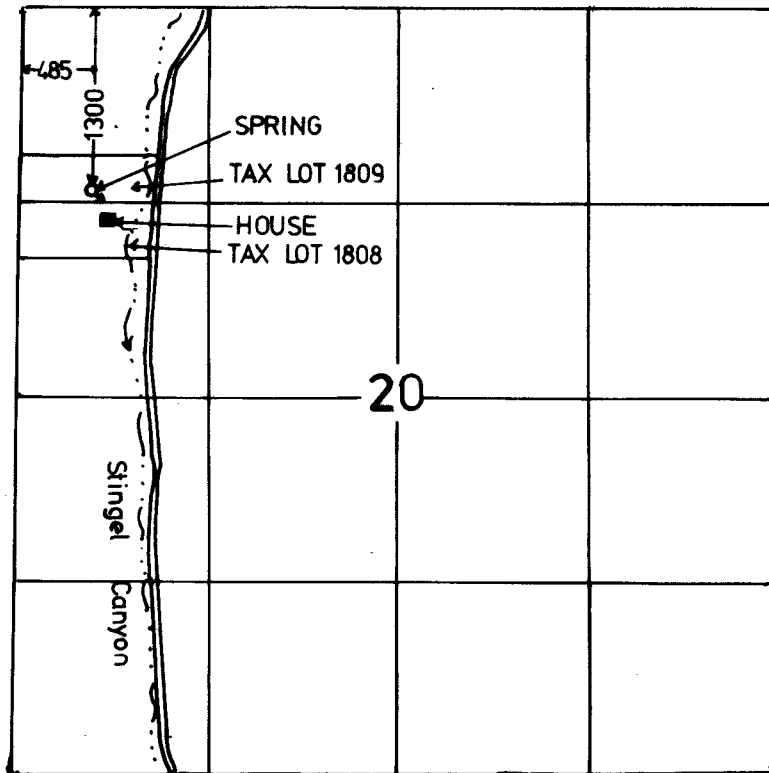

FINAL PROOF SURVEY
UNDER

Application No. 68010 Permit No. 48461
IN NAME OF

~~OF THE ESTATE OF THOMAS H. COOPER~~
James H. Cooper

Surveyed 9-08, 1993, by J. MILLER